

PIKE
B6

MISSISSIPPI BOARD OF WATER COMMISSIONERS

5-18-61 CODED

WATER WELL DRILLERS LOG

CODED B

Date: 5-18, 1961, Driller: Chester Pears County PIKE
(Name)

(1) Owner of Land: J.E. Thornhill
(Name)
RFD, Summit
(Address)

(2) Location: 1/4, 1/4, Sec 34 T4R8
2 miles EAST of Summit
(distance) (direction) (Nearest Town)

(3) Topography: Hilly
(Hilly) (Flat) (Level)

(4) Purpose of Well: Domestic
(Domestic Irrigation
Municipal, Industrial, Other)

Description & Color of Materials Sand, Clay, Red Clay, Shell, etc.	Thick- ness Feet	Depth Feet
Red Clay	17	17
Yellow Sand	18	35
Brown gravel- sand	37	72
Yellow Sand	18	90
sand & Red Clay	5	95
sandy Chalk	42	137
Brownish Sand	8	145
White Sand	25	170
Coarse white sand	10	181

Information upon completion of well:


- (1) Diameter 4 inches.
- (2) Total Depth 181 feet.
- (3) Water Level 31 feet below top of ground.
- (4) Cased to Bottom Size 4"
- (5) Screen: Size 3 3/4", Length 10 ft.
- (6) Were any formations sealed against pollution?
no.

CODED

If YES depth of formation _____

Why _____

Drillers Remarks: _____

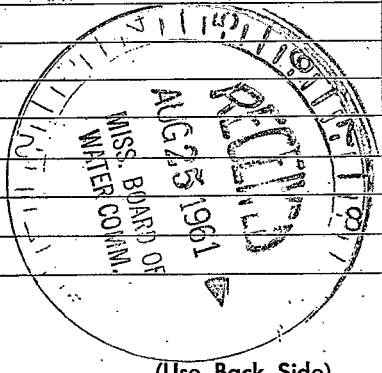

(Use Back Side)

Well No.

[The page contains extremely faint and illegible text, likely bleed-through from the reverse side of the document. The text is scattered across the page and cannot be transcribed.]