

PIKE

MISSISSIPPI BOARD OF WATER COMMISSIONERS

B7

1-29-62 CODED

WATER WELL DRILLERS LOG

CODED

Date: 1-29, 1962, Driller: C. L. Reeves County: PIKE

(Name)

(1) Owner of Land: J. E. Thompson

(Name)

RFD - McLamb

(Address)

(2) Location: 1/4, 1/4, Sec. 32 T4R8

4 miles N.E. of McLamb

(distance)

(direction)

(Nearest Town)

(3) Topography: Flat

(Hilly)

(Flat)

(Level)

(4) Purpose of Well: Domestic

(Domestic Irrigation, Municipal, Industrial, Other)

Description & Color of Materials Sand, Clay, Red Clay, Shell, etc.

Thickness Feet

Clay 0-5 5

sand 5-10 5

Gravel 10-17 7

white chalk 17-90 73

17-90

17-90

Information upon completion of well:

(1) Diameter 2 inches.

(2) Total Depth 132 feet.

(3) Water Level 15 feet below top of ground.

(4) Cased to Bottom size 2"

(5) Screen: Size 1/4", Length 5'

(6) Were any formations sealed against pollution?


yes, no.

If YES depth of formation

Why

Drillers Remarks: Sediment Bad

CODED

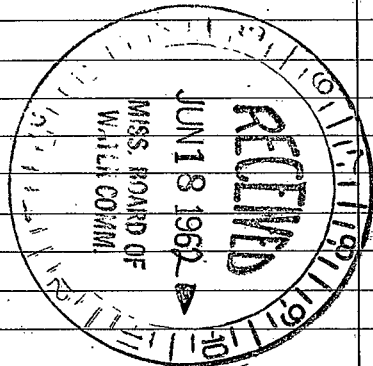

(Use Back Side)

34

[Faint, illegible text covering the majority of the page]