

PIKE  
B10

5-16-62 CODED WATER WELL DRILLERS LOG

CODED

Date: 5-16, 1962 Driller: Chester Reeves County: PIKE

(Name)

(1) Owner of Land: Chas. Clark,  
(Name)  
RFD, Summit  
(Address)

(2) Location: 1/4, 1/4, Sec 24 T. 48  
8 miles N.E. of SUMMIT  
(distance) (direction) (Nearest Town)

(3) Topography: Hilly  
(Hilly) (Flat) (Level)

(4) Purpose of Well: Domestic  
(Domestic Irrigation  
Municipal, Industrial, Other)

Description & Color of Materials Sand, Clay, Red Clay, Shell, etc.	Thick- ness Feet	Depth Feet
<u>Red Clay</u>	<u>20</u>	<u>20</u>
<u>Red sand</u>	<u>42</u>	<u>62</u>
<u>Sand &amp; gravel</u>	<u>10</u>	<u>72</u>

Information upon completion of well:

(1) Diameter 4 inches. (Plastic)

(2) Total Depth 72 feet.

(3) Water Level \_\_\_\_\_ feet below top of ground.

(4) Cased to Bottom, Size 4"

(5) Screen: Size 4", Length 4'


(6) Were any formations sealed against pollution?  
\_\_\_\_\_ yes, ✓ no.

CODED

If YES depth of formation \_\_\_\_\_

Why \_\_\_\_\_

Drillers Remarks: old well  
Rusty.

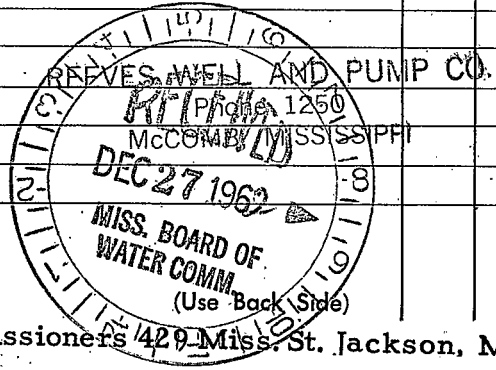

Well No.

1880  
1881  
1882

1899