

PIKE  
B13

MISSISSIPPI BOARD OF WATER COMMISSIONERS CODED

5-26-65 CODED

WATER WELL DRILLERS LOG

Date: 5-26, 1965, Driller: Chester Lewis County, PIKE

(Name)

(1) Owner of Land	Description & Color of Materials Sand, Clay, Red Clay, Shell, etc.	Thick- ness Feet	Depth Feet
shell oil Co Brookhaven (Name) (Address)	Sp. fine gray Red sand	12	12
(2) Location: 1/4, 1/4, Sec 16 T R 8 miles NE Summit (distance) (direction) (Nearest Town)		47	59
(3) Topography: Flat (Hilly) (Flat) (Level)			
(4) Purpose of Well: Industrial (Domestic Irrigation Municipal, Industrial, Other)			

Information upon completion of well:

- (1) Diameter: 4 inches.
- (2) Total Depth: 59 feet.
- (3) Water Level: 12 feet below top of ground.
- (4) Cased to bottom 4' feet.
- (5) Screen: Size 4', Length 7'.
- (6) Were any formations sealed against pollution?  
 yes,  no.


If YES depth of formation \_\_\_\_\_

Why \_\_\_\_\_

Drillers Remarks: good well filled with sand

CODED

water used to coal compressor in Lopez Creek oil field

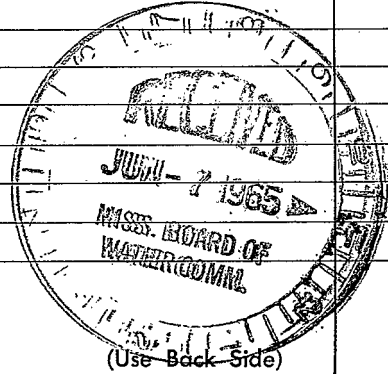

Well No.

1890

1891

1892

1893

1894

1895

1896

1897

1898

1899