

PIKE
B14

MISSISSIPPI BOARD OF WATER COMMISSIONERS

CODED

CODED

6-22-65

WATER WELL DRILLERS LOG

Date: 6-22, 1965, Driller: Chester Reeves County Pike

(Name)

(1) Owner of Land: Jess Williams
 (Name)
RFD Summit
 (Address)

(2) Location: 1/4, 1/4, Sec. 5 T4R8
5 miles N.E. of Summit
 (distance) (direction) (Nearest Town)

(3) Topography: Hilly
 (Hilly) (Flat) (Level)

(4) Purpose of Well: Domestic
 (Domestic Irrigation
 Municipal, Industrial, Other)

Description & Color of Materials Sand, Clay, Red Clay, Shell, etc.	Thick- ness Feet	Depth Feet
<u>Clay</u>	<u>25</u>	<u>25</u>
<u>Sand</u>	<u>10</u>	<u>35</u>
<u>white chalk</u>	<u>35</u>	<u>70</u>
<u>sand & gravel</u>	<u>18</u>	<u>88</u>

Information upon completion of well:

(1) Diameter 4 inches.

(2) Total Depth 88 feet.

(3) Water Level 39 feet below top of ground.

(4) Cased to bottom Size 4

(5) Screen: Size 4", Length 7


(6) Were any formations sealed against pollution?
 _____ yes, no.

If YES depth of formation _____

Why _____

Drillers Remarks: old well
insufficient

CODED

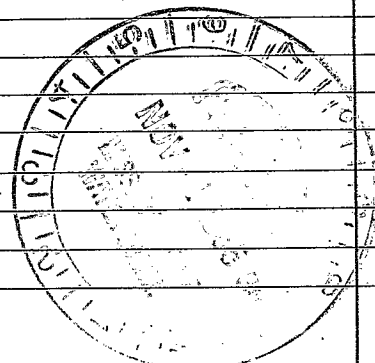

(Use Back Side)

Well No.

