

PIKE

B 17

4-4-66

MISSISSIPPI BOARD OF WATER COMMISSIONERS

WATER WELL DRILLERS LOG


Date: 4-4, 1966, Driller: Chester Reeves, County: Pike. (When well drilled) (Name) (Where well is located)

(1) Owner of Land:	Description & Color of Materials Sand, Clay, Red Clay, Shell, etc.	Thick- ness Feet	Depth Feet
W.M. Haight Rt 3, McComb. (Name) (Address)	Sandy clay yellow sand with small amount of gravel	20	20
(2) Location: 1/4, 1/4, Sec. 31 T4R8 1 mile NE of McComb, Miss. (distance) (direction) (Nearest Town)	medium clay sand & gravel	55	75
(3) Topography: Hills (Hilly) Flat (Flat) Level (Level)			
(4) Purpose of Well: Domestic (Domestic Irrigation Municipal, Industrial, Other)			

Information upon completion of well:

- (1) Diameter: 4 inches.
- (2) Total Depth: 98 feet.
- (3) Water Level: 70 feet below top of ground.
- (4) Cased to: Bottom Size 4"
- (5) Screen: Size 4", Length 6'
- (6) Were any formations sealed against pollution?  
yes, no.

CODED

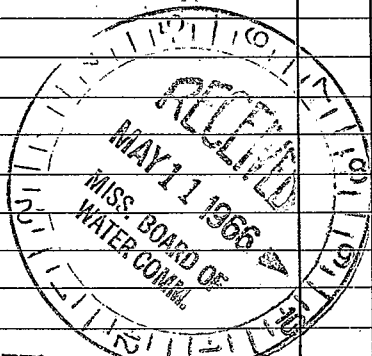

If YES depth of formation \_\_\_\_\_

Why \_\_\_\_\_

Drillers Remarks: redwell had

Yield in gpm: 15

Size pump: 1/2 HP Sub

Type power: Electric

BEEVES WELL & PUMP CO. P. O. BOX 71 - PHONE 684-1451 McCOMB, MISS.

