

CODED

MISSISSIPPI  
BOARD OF WATER COMMISSIONERS

416 North State Street  
Jackson, Mississippi 39201

CODED

WATER WELL DRILLERS LOG

6-23  
date well completed

1966 Fitzgerald Water Well Serv  
firm name

Pike  
county well located

LANDOWNER: Bill Freeman

description of formations encountered

from

to

Summit Rly Miss  
(mailing address)

WELL LOCATION:

sec 20 T 4 N R 8 E  
S W  
5 miles NE of Summit  
(distance) (direction) (nearest town)

Top Soil Red Clay	0	15
Red Sand	25	40
Red Sand + gravel	20	80
White Chalk	40	120
Progressive (barney sand)	60	180
White Chalk	180	


WELL PURPOSE: Home  
(home, irrigation, municipal, industrial)

WELL COMPLETION DATA:

- (1) diameter (inches) 4
- (2) total depth (feet) 178
- (3) static water level (feet) 85 below top of ground.
- (4) casing plastic, 170 (material), (depth)  
4 (size) if telescope see back.
- (5) screen 8' 170 (length), (depth to top)  
4" plastic (size), (material)
- (6) pump Submk 12 (HP), (yield gpm)  
Elec (type power)
- (7) electric log NO (yes or no)
- (8) how well bottom plugged Wood Peg


CODED

DRILLERS REMARKS:

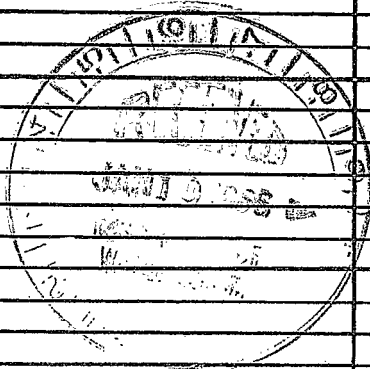

If well telescopes please  
sketch and show depths.

GROUND LEVEL

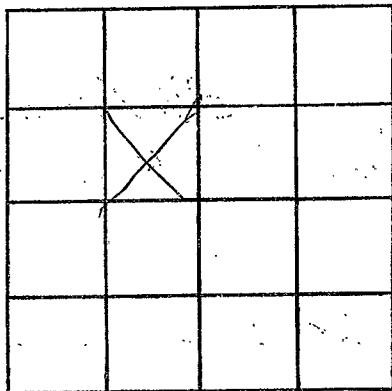

SECTION 20

Please indicate well location X.

ADDITIONAL INFORMATION

If more than one screen,  
show locations of each on sketch.