

Pike  
 B20 CODED  
 3-67

MISSISSIPPI  
 BOARD OF WATER COMMISSIONERS  
 416 North State Street  
 Jackson, Mississippi 39201

WATER WELL DRILLERS LOG

Mar 2 1967 Fitzgerald Well Service Pike  
 date well completed firm name county well located

LANDOWNER: Jahnnie Barnett

description of formations encountered

from to

Route 3 Summit  
 (mailing address)

Red clay	0	25
Red sand	25	60
White chalk	60	98
Red fine sand	98	165
Coarse sand	165	180

WELL LOCATION:

sec. 20 T. 4 N. R. 8 E.  
5 miles NE of Summit  
 (distance) (direction) (nearest town)

WELL PURPOSE:


(home, irrigation, municipal, industrial)

CODED

WELL COMPLETION DATA:


- diameter (inches) 4"
- total depth (feet) 180'
- static water level (feet) 65' below top of ground.
- casing PLASTIC, 172'  
 (material) (depth)  
4" if telescope see back.  
 (size)
- screen 8', 172'  
 (length) (depth to top)  
4", Plastic  
 (size) (material)
- pump ? ?  
 (HP) (yield gpm)  
Electric  
 (type power)
- electric log No  
 (yes or no)  
 (organization running log)
- how well bottom plugged Wood plug

DRILLERS REMARKS:

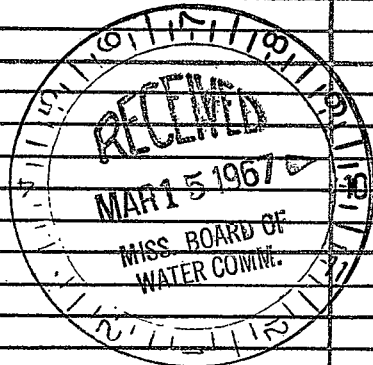

If well telescopes please sketch and show depths.

GROUND LEVEL

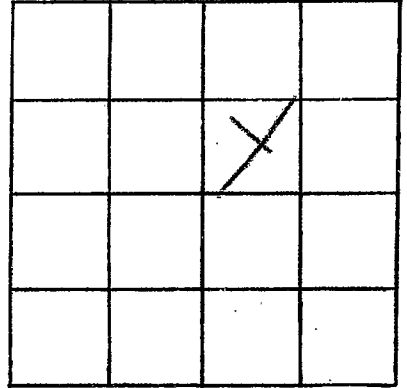

SECTION 20

Please indicate well location X.

ADDITIONAL INFORMATION

If more than one screen, show locations of each on sketch.