

Pike
B23

MISSISSIPPI BOARD OF WATER COMMISSIONERS

CODED

9-66 CODED

WATER WELL DRILLERS LOG

Date: 9 Sept., 1966, Driller: J. T. Covington Co. Summit County, Pike
(Name)

- (1) Owner of Land: Pess Kelly
(Name)
Summit Miss.
(Address)
- (2) Location: NE 1/4, SW 1/4, Sec. 20 T. 14 R. 3
2 miles East of Summit
(distance) (direction) (Nearest Town)
- (3) Topography: ✓
(Hilly) (Flat) (Level)
- (4) Purpose of Well: Domestic
(Domestic Irrigation
Municipal, Industrial, Other)


Description & Color of Materials Sand, Clay, Red Clay, Shell, etc.	Thick- ness Feet	Depth Feet
Clay	60	
Sand - Red	20	80
Sand & Rock	40	120
Chalk	20	140
Sand	28	168

Information upon completion of well:

- (1) Diameter 4" inches.
- (2) Total Depth 168 feet.
- (3) Water Level 90 feet below top of ground.
- (4) Cased to 168, Size 4"
- (5) Screen: Size 4", Length 6'
- (6) Were any formations sealed against pollution?
no

CODED

If YES depth of formation _____
Why _____
Drillers Remarks: _____

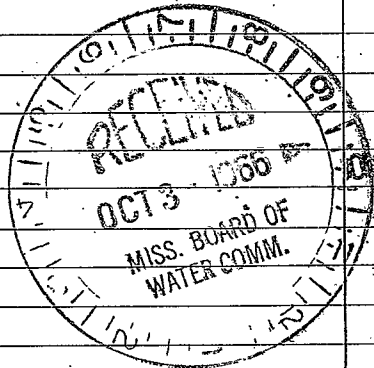

(Use Back Side)

Well No.

