

Pike
B25
11-66 CODED

MISSISSIPPI BOARD OF WATER COMMISSIONERS

WATER WELL DRILLERS LOG

Date: 75 Nov, 1966, Driller: J.T. Covington County: Pike
(Name)

(1) Owner of Land: Alton Mayall
(Name)
Summit
(Address)

(2) Location: NW 1/4 NW 1/4, Sec. 35 T11 R8,
.6 miles East of Summit
(distance) (direction) (Nearest Town)

(3) Topography: (Hilly) (Flat) (Level)

(4) Purpose of Well: Domestic
(Domestic Irrigation
Municipal, Industrial, Other)

Description & Color of Materials Sand, Clay, Red Clay, Shell, etc.	Thick- ness Feet	Depth Feet
<u>Clay</u>	<u>20</u>	<u>20</u>
<u>clay sand</u>	<u>15</u>	<u>35</u>
<u>sand</u>	<u>60</u>	<u>95</u>
<u>sand & pebbles</u>	<u>7</u>	<u>97</u>

Information upon completion of well:

(1) Diameter 4" inches.

(2) Total Depth 97 feet.

(3) Water Level 60 feet below top of ground.

(4) Cased to 97', Size 4"

(5) Screen: Size 4", Length 6'


(6) Were any formations sealed against pollution?
_____ yes, no.

If YES depth of formation _____

Why _____

Drillers Remarks: _____

CODED

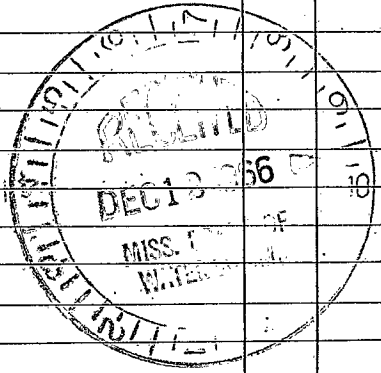

(Use Back Side)

Well No.

