

Pipe CODED
 B27
 11-66

MISSISSIPPI
 BOARD OF WATER COMMISSIONERS
 416 North State Street
 Jackson, Mississippi 39201

WATER WELL DRILLERS LOG

NOV. 28 1966 REEVES WELL & PUMP PIKE
 date well completed firm name county well located

LANDOWNER: Mack Lofton


description of formations encountered	from	to
Red clay	0	20
Red sand	20	60
Sand & gravel	60	75
White chalk	75	130
Clay & gravel & sand	130	144

RFD Summit Miss
 (mailing address)

WELL LOCATION:
 sec. 17 T 4 N R 9 E
 S W
 1/4 miles NE of Summit
 (distance) (direction) (nearest town)

WELL PURPOSE: Domestic
 (home, irrigation, municipal, industrial)

- WELL COMPLETION DATA:
- (1) diameter (inches) 4"
 - (2) total depth (feet) 144
 - (3) static water level (feet) 92 below above top of ground.
 - (4) casing (material) (depth)
 No casing
 - (5) screen (length) (depth to top)
 No screen
 - (6) pump (HP) (yield gpm)
 No pump
 - (7) electric log (yes or no)
 No electric log
 - (8) how well bottom plugged

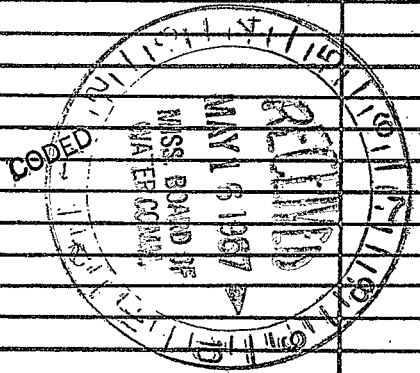


This well was salty - casing pulled apart & abandoned - another well drilled between 700 and 800 ft from house.

DRILLERS REMARKS:

If well telescopes please sketch and show depths.

GROUND LEVEL

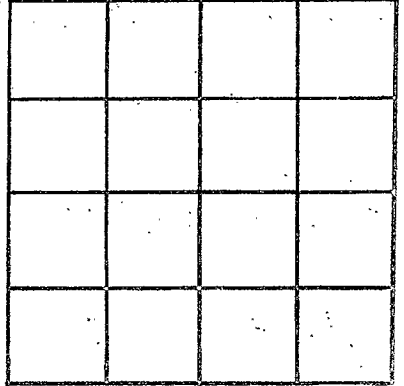

SECTION _____

Please indicate well location X.

ADDITIONAL INFORMATION

Lined area for additional information.

If more than one screen, show locations of each on sketch.