

Pike
 B28 CODED
 11-66

MISSISSIPPI
 BOARD OF WATER COMMISSIONERS
 416 North State Street
 Jackson, Mississippi 39201

WATER WELL DRILLERS LOG

Nov 30 1966 Reynolds Well Pump Co Pike
 date well completed firm name county well located

LANDOWNER: Wick Cofton

description of formations encountered

from to

RFD Summit
 (mailing address)

red clay 0 20
~~red sand~~ 20 65
~~white sand~~ 65 78
sand & gravel 65 78
white chalk 78 130
sand & gravel 130 150

WELL LOCATION:

sec. 17 T. 4 N. R. 2 E. S. 1 W.
4 miles NE of Summit
 (distance) (direction) (nearest town)

WELL PURPOSE: Domestic
 (home, irrigation, municipal, industrial)

WELL COMPLETION DATA:


- (1) diameter (inches) 4"
- (2) total depth (feet) 150
- (3) static water level (feet) 90 below above top of ground.
- (4) casing Plastic, Bottomless
 (material) (depth)
- 4 if telescope see back.
 (size)
- (5) screen 6' 144
 (length) (depth to top)
- 4 plastic
 (size) (material)
- (6) pump 3/4 Sub 15
 (HP) (yield gpm)
- Electric
 (type power)
- (7) electric log no
 (yes or no)

CODED

(organization running log)


(8) how well bottom plugged woolen

DRILLERS REMARKS:

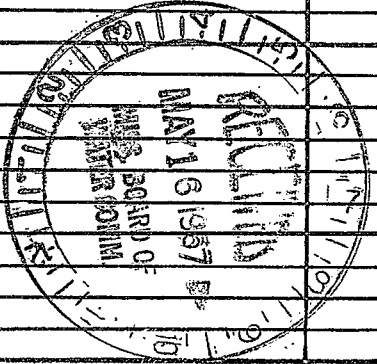

If well telescopes please sketch and show depths.

GROUND LEVEL

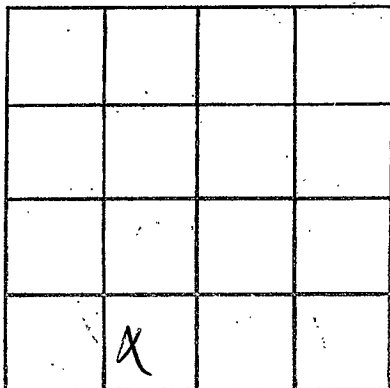

SECTION 17

Please indicate well location X.

ADDITIONAL INFORMATION

If more than one screen, show locations of each on sketch.