

Pike  
 CODED  
 B29  
 3-67

MISSISSIPPI  
 BOARD OF WATER COMMISSIONERS  
 416 North State Street  
 Jackson, Mississippi 39201

WATER WELL DRILLERS LOG

Mar 8 1967 Fitzgerald Well Drilling Pike  
 date well completed firm name county well located

LANDOWNER: H. T. Buie

description of formations encountered

from to

Rural Route, Summit  
 (mailing address)

red clay	0	20
red sand	20	30
white chalk	30	40
blue chalk	40	80
fine sand & clay	80	95
course sand & gravel	95	100

WELL LOCATION:


sec. 1 T. 4 N. R. 8 E.  
5 10 miles ENE of Summit  
 (distance) (direction) (nearest town)

WELL PURPOSE: Home  
 (home, irrigation, municipal, industrial)

WELL COMPLETION DATA:

- diameter (inches) 4
- total depth (feet) 108
- static water level (feet) 50 below top of ground.
- casing Plastic, 100,  
 (material) (depth)  
4" if telescope see back.  
 (size)
- screen 9', 100  
 (length) (depth to top)  
4", Plastic  
 (size) (material)
- pump ? ?  
 (HP) (yield gpm)  
Electric  
 (type power)
- electric log No  
 (yes or no)  
 (organization running log)
- how well bottom plugged around per


CODED

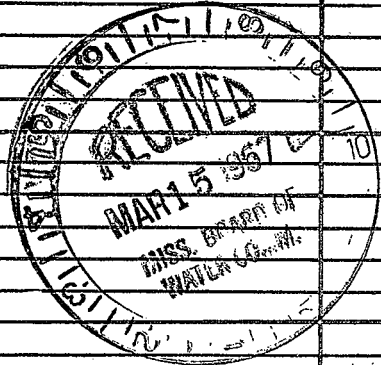

DRILLERS REMARKS:

If well telescopes please sketch and show depths.

GROUND LEVEL

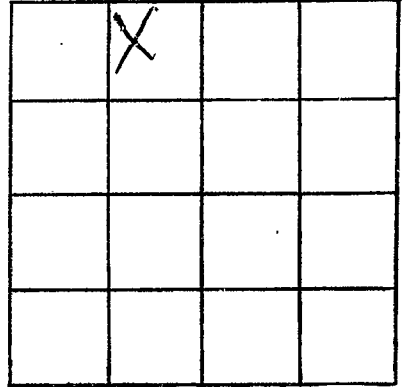

SECTION         

Please indicate well location X.

ADDITIONAL INFORMATION

If more than one screen,  
show locations of each on sketch.