

Pike  
B30  
3-67

MISSISSIPPI  
BOARD OF WATER COMMISSIONERS  
416 North State Street  
Jackson, Mississippi 39201

WATER WELL DRILLERS LOG

3-16 1967 Fitzgerald Well Serv Pike  
date well completed firm name county well located

LANDOWNER Robert Turner  
Ref Summit

description of formations encountered	from	to
top soil	0	20
Small Rock	22	53
hard gravel	55	85
Chalk	95	103
Rock	103	168
Chalky sand	104	168
hard gravel	168	176

(mailing address)


WELL LOCATION:  
sec 21 T 4 N R 8 E  
S W  
6 miles NE of Summit  
(distance) (direction) (nearest town)

WELL PURPOSE: home  
(home, irrigation, municipal, industrial)

WELL COMPLETION DATA:

- (1) diameter (inches) 4
- (2) total depth (feet) 176
- (3) static water level (feet) 90 below above top of ground.
- (4) casing plastic 168,  
(material) (depth)  
4"  
(size) if telescope see back.
- (5) screen 8, 168  
(length) (depth to top)  
4", plastic  
(size) (material)
- (6) pump 1/2 Oct 10  
(HP) (yield gpm)  
Elec  
(type power)
- (7) electric log No  
(yes or no)  
  
(organization running log)
- (8) how well bottom plugged None


CODED

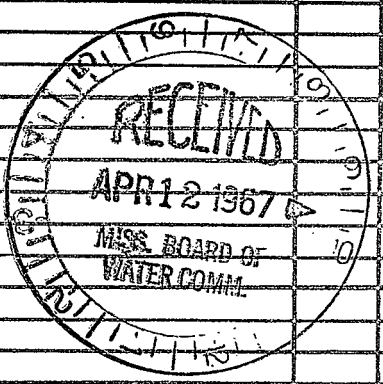

DRILLERS REMARKS:

If well telescopes please sketch and show depths.

GROUND LEVEL

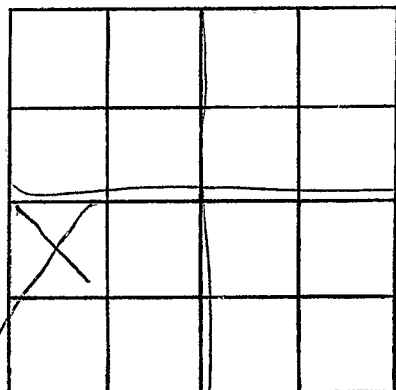

SECTION 2/

Please indicate well location X.

ADDITIONAL INFORMATION

If more than one screen, show locations of each on sketch.