

Pike  
 B31 CODED  
 4-67

MISSISSIPPI  
 BOARD OF WATER COMMISSIONERS  
 416 North State Street  
 Jackson, Mississippi 39201

WATER WELL DRILLERS LOG

Apr 6 1967 Fitzgerald Well Service Pike  
 date well completed firm name county well located

LANDOWNER:  
Brother Fidler  
Summit, Rt.  
 (mailing address)

WELL LOCATION:  
 sec. 9 T. 4 N R. 8 E  
7 miles NE of Summit  
 (distance) (direction) (nearest town)

WELL PURPOSE:  
 (home, irrigation, municipal, industrial)

WELL COMPLETION DATA:

(1) diameter (inches) 4

(2) total depth (feet) 233

(3) static water level (feet) 65' below above top of ground.

(4) casing Plastic, 225'  
 (material) (depth)  
4" If telescope see back.  
 (size)

(5) screen 8', 225'  
 (length) (depth to top)  
4", Plastic  
 (size) (material)


(6) pump 7 7  
 (HP) (yield gpm)  
elec  
 (type power)

(7) electric log no  
 (yes or no)  
 (organization running log)

(8) how well bottom plugged wood peg

description of formations encountered	from	to
Red clay	0	10
Coarse sand & gravel	10	40
Fine & coarse sand & gravel	40	60
Coarse sand	60	70
Red chalk	70	73
Coarse sand & gravel	73	78
white chalk	78	81
medium sand	81	105
white chalk	105	120
Coarse & Fine sand	120	130
white chalk	130	135
Blue chalk	135	215
Coarse sand & gravel	215	233


CODED

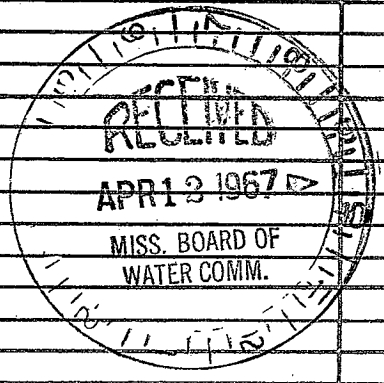

DRILLERS REMARKS:

If well telescopes please sketch and show depths.

GROUND LEVEL

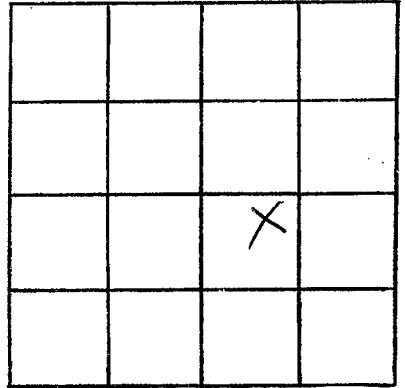

SECTION 9

Please indicate well location X.

ADDITIONAL INFORMATION

If more than one screen, show locations of each on sketch.