

Pike
B3V
4-67

MISSISSIPPI
BOARD OF WATER COMMISSIONERS CODED
416 North State Street
Jackson, Mississippi 39201

WATER WELL DRILLERS LOG

CODED

Apr. 28 1967 Fitzgould well driller Pike
date well completed firm name county well located

LANDOWNER: Earnest M. Dinkell

description of formations encountered

from to

ROUTE 1

Summit, Miss.
(mailing address)

WELL LOCATION:


sec. 29 T. 4 N. R. 8 E
5 S. W
2 miles E of Summit
(distance) (direction) (nearest town)

WELL PURPOSE: Home
(home, irrigation, municipal, industrial)

WELL COMPLETION DATA:

- (1) diameter (inches) 2
- (2) total depth (feet) 63
- (3) static water level (feet) 50 below above top of ground.
- (4) casing Galv. 57'
(material) (depth) CODED
- 2 if telescope see back.
(size)
- (5) screen 6' 57'
(length) (depth to top)
- 1 1/4" Brass
(size) (material)
- (6) pump 1/2 3
(HP) (yield gpm)
- elec
(type power)
- (7) electric log no
(yes or no)
- _____
(organization running log)
- (8) how well bottom plugged surface
Cylinder

DRILLERS REMARKS:

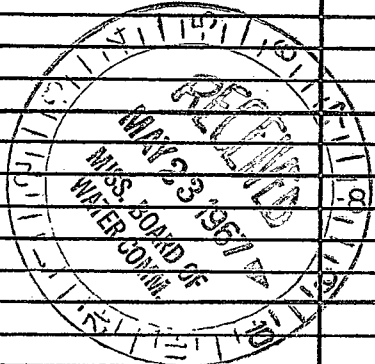

If well telescopes please sketch and show depths.

GROUND LEVEL

	X		

SECTION 29

Please indicate well location X.

ADDITIONAL INFORMATION

If more than one screen,
show locations of each on sketch.