

**MISSISSIPPI
BOARD OF WATER COMMISSIONERS
416 North State Street
Jackson, Mississippi 39201**

WATER WELL DRILLERS LOG

Pike
B33
5-67 CODED

May 17 19*62* *Keene Well Pump* *Pike*
date well completed firm name county well located

LANDOWNER: *Vance Tower*

RFD, Summit, Miss
(mailing address)

WELL LOCATION:
sec. *6* T *4* N R. *6* E
4 miles *N.W.* of *Summit*
(distance) (direction) (nearest town)

WELL PURPOSE: *Domestic*
(home, irrigation, municipal, industrial)


WELL COMPLETION DATA:

- (1) diameter (inches) *4*
- (2) total depth (feet) *45*
- (3) static water level (feet) *2* below above
top of ground. CODED
- (4) casing *Plastic Ballon*
(material) (depth)
- If telescope see back.
(size)
- (5) screen *6'* *39'*
(length) (depth to top)
4" *plastic*
(size) (material)
- (6) pump *10*
(HP) (yield gpm)
elec.
(type power)
- (7) electric log *NO*
(yes or no)
- (organization running log)
- (8) how well bottom plugged *was plugged*

description of formations encountered	from	to
<i>black top soil</i>	<i>0</i>	<i>8</i>
<i>fine yellow sand</i>	<i>8</i>	<i>30</i>
<i>coarse white sand</i>	<i>30</i>	<i>45</i>

DRILLERS REMARKS:

no problems well

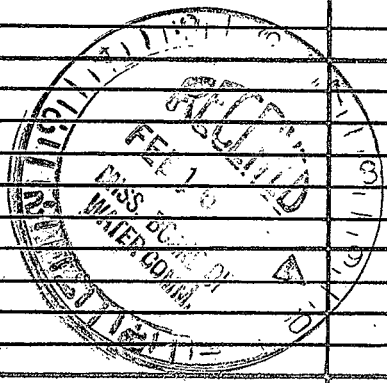

If well telescopes please sketch and show depths.

GROUND LEVEL

			X

SECTION 6

Please indicate well location X.

ADDITIONAL INFORMATION

If more than one screen,
show locations of each on sketch.