

**MISSISSIPPI  
BOARD OF WATER COMMISSIONERS**  
416 North State Street  
Jackson, Mississippi 39201

**WATER WELL DRILLERS LOG**

PIKE  
B34  
5-67

CODED

May 11 1969 Fitzgerald Water Well Pike  
date well completed firm name county well located

LANDOWNER: Jack Jackson

description of formations encountered from to

RH Summit  
(mailing address)

Top soil & clay 0 20  
Red Sand 20 68  
Gravel Sand 68 72  
Chalk 72 92  
Fine White Sand 92 160  
Sand & Gravel 160 175

WELL LOCATION:  
sec 28 T 4 N R 8 E S  
8 miles NE of Natchez  
(distance) (direction) (nearest town)

WELL PURPOSE: home  
(home, irrigation, municipal, industrial)

WELL COMPLETION DATA:

- (1) diameter (inches) 4
- (2) total depth (feet) 176
- (3) static water level (feet) 80 below top of ground.
- (4) casing, plastic 168 (material) (depth)
- 4 (size) if telescope see back.
- (5) screen 81 168 (length) (depth to top)
- 4 plastic (size) (material)
- (6) pump 1/2 sub 12 (HP) (yield gpm)
- Elec (type power)
- (7) electric log No (yes or no)

CODED

(organization running log)


(8) how well bottom plugged Mud peg

DRILLERS REMARKS:



If well telescopes please sketch and show depths.

GROUND LEVEL

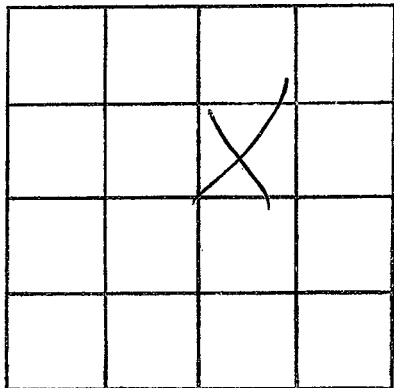

SECTION 28

Please indicate well location X.

ADDITIONAL INFORMATION

If more than one screen, show locations of each on sketch.