

Oike
B36
9-67

MISSISSIPPI
BOARD OF WATER COMMISSIONERS
416 North State Street
Jackson, Mississippi 39201

WATER WELL DRILLERS LOG

Sept 15 1967 *Keeler well Okemka Oike*
date well completed firm name county well located

LANDOWNER: *J. A. Garner*
PTD 1
Summit Miss.
(mailing address)

description of formations encountered	from	to
<i>Red clay</i>	<i>0</i>	<i>18</i>
<i>Red sandy gravel</i>	<i>18</i>	<i>60</i>
<i>Small gravel and sand</i>	<i>60</i>	<i>73</i>

WELL LOCATION:
sec *24* T *4* N R *4* E
8 miles *E-NE* of *Summit*
(distance) (direction) (nearest town)

WELL PURPOSE: *Home*
(home, irrigation, municipal, industrial)

WELL COMPLETION DATA:

(1) diameter (inches) *4"*
(2) total depth (feet) *73*
(3) static water level (feet) *60* below above top of ground.
(4) casing *Plastic bottom*
(material) (depth)

_____ if telescope see back.
(size)

(5) screen *6'* *67'*
(length) (depth to top)
4" *Plastic*
(size) (material)

(6) pump *old pump* *6*
(HP) (yield gpm)
elect
(type power)


(7) electric log *No*
(yes or no)

_____ (organization running log)

(8) how well bottom plugged *wooden peg*


DRILLERS REMARKS: *old well bad*

CODED

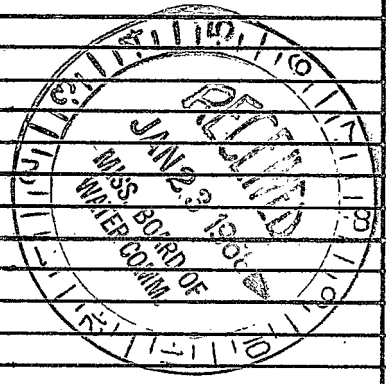

If well telescopes please sketch and show depths.

GROUND LEVEL

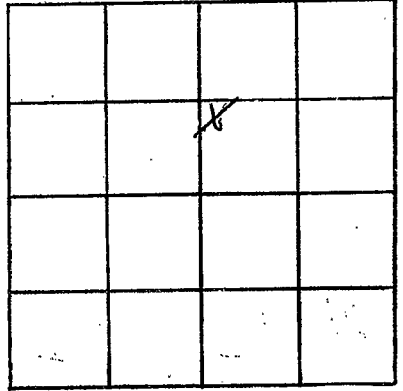

SECTION 24

Please indicate well location X.

ADDITIONAL INFORMATION

If more than one screen, show locations of each on sketch.