

Pike
B37 CODED
12-67

MISSISSIPPI
 BOARD OF WATER COMMISSIONERS
 416 North State Street
 Jackson, Mississippi 39201

WATER WELL DRILLERS LOG

12-30 1967 Litgenard Water Well Pike
 date well completed firm name county well located

LANDOWNER: Tommye (Mrs) //

description of formations encountered from to

Summit Miss RT
 (mailing address)

Top soil & clay	0	25
Sand	25	75
Gravel	75	85
Chalk	85	103
In & out of fine sand & clays	103	170
Sand & gravel	170	178
Chalk	178	

WELL LOCATION:
 sec. 9 T. 4 N. ✓ R. 8 E
3 miles NE of Summit
 (distance) (direction) (nearest town)

WELL PURPOSE: home
 (home, irrigation, municipal, industrial)

WELL COMPLETION DATA:


- (1) diameter (inches) 4
- (2) total depth (feet) 177
- (3) static water level (feet) 80 below above top of ground.
- (4) casing plastic 1 7/8 (material) (depth)
4 1/2 if telescope see back. (size)
- (5) screen 6 , 171 (length) (depth to top)
4 , Sch 40 (size) (material)
- (6) pump — (HP) (yield gpm)
Elec (type power)
- (7) electric log NO (yes or no)

(organization running log)

(8) how well bottom plugged Wood peg


DRILLERS REMARKS:

CODED

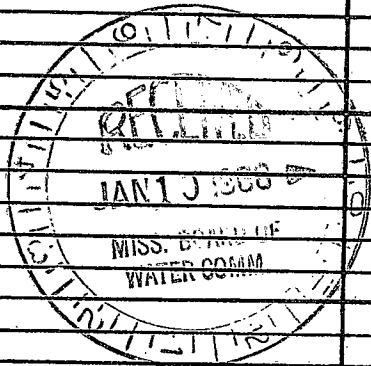

If well telescopes please sketch and show depths.

GROUND LEVEL

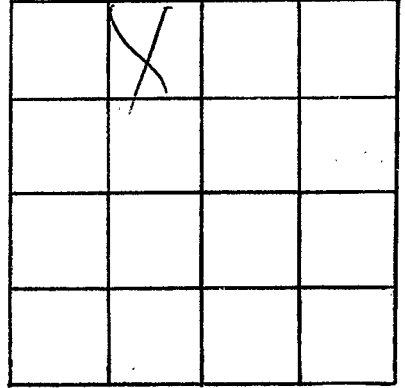

SECTION 9

Please indicate well location X.

ADDITIONAL INFORMATION

If more than one screen,
show locations of each on sketch.