

Pike
 B38 CODED
 7-67

MISSISSIPPI
 BOARD OF WATER COMMISSIONERS
 416 North State Street
 Jackson, Mississippi 39201

WATER WELL DRILLERS LOG

July 11 67 Kelso Well Drilling Co. Pike
 date well completed firm name county well located

LANDOWNER: Ernest Smith
 RFD - Summit -
 (mailing address)

WELL LOCATION:
 sec. 14 T. 4 N R. 4 E
 3 miles NE of Summit
 (distance) (direction) (nearest town)


WELL PURPOSE: same
 (home, irrigation, municipal, industrial)

WELL COMPLETION DATA:

- (1) diameter (inches) 4"
- (2) total depth (feet) 150
- (3) static water level (feet) 84 below top of ground.
- (4) casing Plaster Bottom
 (material) (depth)
- (size) if telescope see back.
- (5) screen 6' 144'
 (length) (depth to top)
 4" Plaster
 (size) (material)
- (6) pump 3/4 HP - 15
 (HP) (yield gpm)
 elect.
 (type power)
- (7) electric log NO.
 (yes or no)
- (organization running log)
- (8) Work plugged

| description of formations encountered | from | to |
|---------------------------------------|------|-----|
| yellow clay | 0 | 25 |
| yellow sand | 25 | 60 |
| white chalk | 60 | 90 |
| gravel with sand | 90 | 140 |
| coarse sand | 140 | 150 |

CODED

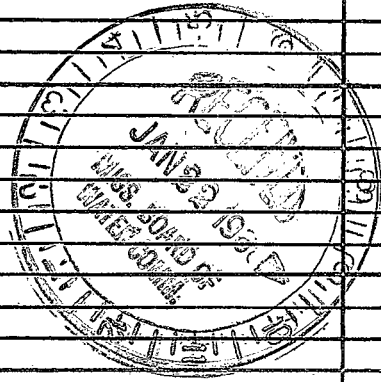

DRILLERS REMARKS:
 Newhouse.

If well telescopes please
sketch and show depths.

GROUND LEVEL

| | | | |
|--|--|--|---|
| | | | X |
| | | | |
| | | | |
| | | | |

SECTION 19

Please indicate well location X.

ADDITIONAL INFORMATION

If more than one screen,
show locations of each on sketch.