

PIKE
B40

MISSISSIPPI BOARD OF WATER COMMISSIONERS

12-7-63 CODED WATER WELL DRILLERS LOG

CODED

Date: 12-7, 1963, Driller: Chester Reeves County: Pike
(Name)

(1) Owner of Land: Willie Butler
(Name)
RFD Summit
(Address)

(2) Location: 1/4, 1/4, Sec 20 T4 R 8,
1/4 miles N.E., of Summit
(distance) (direction) (Nearest Town)

(3) Topography: Hilly
(Hilly) (Flat) (Level)

(4) Purpose of Well: Domestic
(Domestic Irrigation
Municipal, Industrial, Other)

Description & Color of Materials Sand, Clay, Red Clay, Shell, etc.	Thick- ness Feet	Dep Fe
<u>Red Clay</u>	<u>20-20</u>	
<u>Red sand</u>	<u>20-40</u>	
<u>Sand & gravel</u>	<u>30-40</u>	
<u>Blue shale</u>	<u>80-150</u>	
<u>fine sand</u>	<u>43-193</u>	
<u>coarse sand</u>	<u>27-220</u>	

Information upon completion of well:

(1) Diameter 4 inches.


(2) Total Depth 220 feet.

(3) Water Level 90 feet below top of ground.

(4) Cased to 193, Size 4"

(5) Screen: Size 1/4, Length 20'
with bal-1 1/4" blank

(6) Were any formations sealed against pollution?
yes, no.

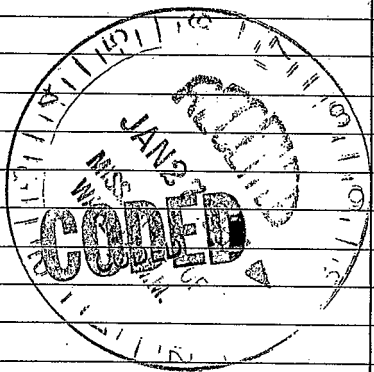

If YES depth of formation _____

Why _____

Drillers Remarks: old well
not good.

REEVES WELL & PUMP CO.
P. O. BOX 71 - PHONE 684-1451
McCOMB, MISS.

(Use Back Side)

Well No.

THE UNIVERSITY OF CHICAGO
LIBRARY
540 EAST 57TH STREET
CHICAGO, ILL. 60637