

PIKE
B43

MISSISSIPPI BOARD OF WATER COMMISSIONERS

6-15-66

CODED

WATER WELL DRILLERS LOG

CODED

Date: June 15, 1966, Driller: Chester Reeves County Pike
(When well drilled) (Name) (Where well is located)

(1) Owner of Land	Description & Color of Materials Sand, Clay, Red Clay, Shell, etc.	Thick- ness Feet	Depth Feet
<u>Joe C Brown</u> (Name) <u>RFD Summit</u> (Address)	<u>Clay gravel</u>	<u>25</u>	<u>25</u>
(2) Location: <u>1/4</u> , <u>1/4</u> , Sec. <u>15</u> T <u>7R</u> 8,	<u>Hard gravel</u>	<u>15</u>	<u>40</u>
<u>7</u> miles <u>NE</u> of <u>Summit</u>	<u>Serp yellow sand</u>	<u>60</u>	<u>100</u>
(3) Topography: <u>Hilly</u>	<u>Coarse sand</u>	<u>10</u>	<u>110</u>
(4) Purpose of Well: <u>Domestic</u>			

Information upon completion of well:

- (1) Diameter 4 inches.
- (2) Total Depth 110 feet.
- (3) Water Level 38 feet below top of ground.
- (4) Cased to bottom Size 4"
- (5) Screen: Size 4", Length 6'
- (6) Were any formations sealed against pollution?
 yes, no.

If YES depth of formation _____

Why _____


Drillers Remarks: Newhouse

Yield in gpm: 15

Size pump: 1 HP Sub

Type power: electric

CODED

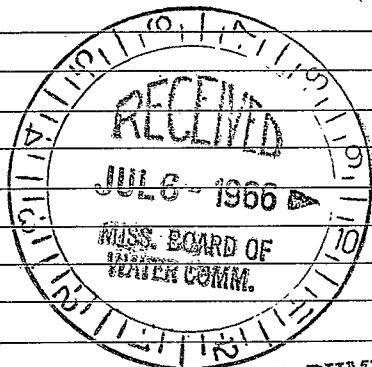

REEVES WELL & PUMP CO.
P. O. BOX 71 - PHONE 684-1451
MCCOMB, MISS.

