

PIKE
B 45
8-6-64

MISSISSIPPI BOARD OF WATER COMMISSIONERS

CODED

WATER WELL DRILLERS LOG

Date: 8-6, 1964, Driller: Chester Reeves County Pike

CODED

(Name)

(1) Owner of Land: Willie Walker
(Name)
RFD 1, Ruth
(Address)

(2) Location: 1/4, 1/4, Sec. 2 T 7 R 8
8 miles NE of Summit
(distance) (direction) (Nearest Town)

(3) Topography: Hilly
(Hilly) (Flat) (Level)

(4) Purpose of Well: Domestic
(Domestic Irrigation
Municipal, Industrial, Other)

| Description & Color of Materials Sand, Clay, Red Clay, Shell, etc. | Thick- ness Feet | Depth Feet |
|---|------------------------|---------------|
| <u>Hard Red Clay</u> | <u>20</u> | <u>20</u> |
| <u>Red Sandy Clay</u> | <u>45</u> | <u>65</u> |
| <u>Sand & gravel</u> | <u>12</u> | <u>77</u> |
| <u>Clayey gravel</u> | <u>23</u> | <u>100</u> |
| <u>Clay Sand</u> | | |
| <u>gravel</u> | <u>12</u> | <u>112</u> |

Information upon completion of well:

(1) Diameter 4" inches.

(2) Total Depth 112 feet.

(3) Water Level 77 feet below top of ground.

(4) Cased to bottom

(5) Screen: Size 4, Length 2'


(6) Were any formations sealed against pollution?
_____ yes, _____ no.

CODED

If YES depth of formation _____

Why _____

Drillers Remarks: all well went dry

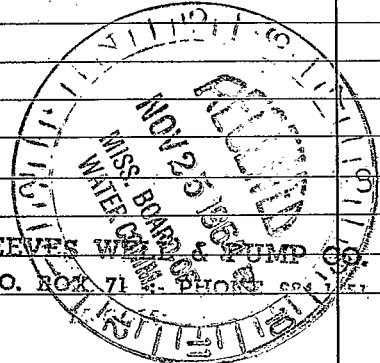

(Use Back Side)

Well No.

