

CODED

PIKE  
B48  
4-68

CODED

MISSISSIPPI  
BOARD OF WATER COMMISSIONERS  
416 North State Street  
Jackson, Mississippi 39201

WATER WELL DRILLERS LOG

April 24 1968 Kerns well & pump Co - Pike  
date well completed firm name county well located

LANDOWNER

Thornhill  
(mailing address)

description of formations encountered

from

to

red clay	0	28
Sand & gravel	28	62
bed chalk & sand	62	90
fine white sand with sand gravel	90	135
Red gravel & sand	135	150

WELL LOCATION:

sec 5 T 4 N R 8 E  
5 miles NE of Summit  
(distance) (direction) (nearest town)

WELL PURPOSE:

Same  
(home, irrigation, municipal, industrial)

WELL COMPLETION DATA:

- (1) diameter (inches) 4"
- (2) total depth (feet) 150
- (3) static water level (feet) 88 below top of ground
- (4) casing Plastic Bottom (material) (depth)
- (5) screen 6' (length) 144" (depth to top) Plastic (material)
- (6) pump 1/2 sub 1/2 (HP) (yield gpm) Elect (type power)
- (7) electric log NO (yes or no)

CODED

(organization running log)

(8) how well bottom plugged  
wooden plug


DRILLERS REMARKS:

red ball pump  
well ball

APR 27 1968  
MISS. BOARD OF  
WATER COMMISSIONERS

If well telescopes please sketch and show depths.

GROUND LEVEL

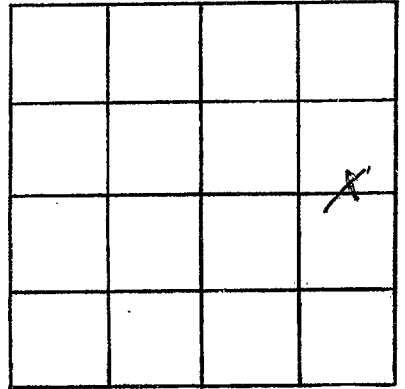

SECTION 5

Please indicate well location X.

ADDITIONAL INFORMATION

If more than one screen,  
show locations of each on sketch.