

**MISSISSIPPI
BOARD OF WATER COMMISSIONERS**
416 North State Street
Jackson, Mississippi 39201

WATER WELL DRILLERS LOG

PIKE CODED
B 49
4-68

April 10 1968 Reines Well Pump Pike
date well completed firm name county well located

LANDOWNER: C. C. Witham
M. C. Lamb
(mailing address)

description of formations encountered	from	to
yellow clay	0	12
yellow clay & gravel	12	20
sandy gravel	20	30
white chalk	30	40
fine white sand	40	120
Coarse sand & pea gravel	120	130

WELL LOCATION:
sec 33 T 4 N R 8 E
2 1/2 miles NE of McComb
(distance) (direction) (nearest town)

WELL PURPOSE: Drum
(home, irrigation, municipal, industrial)

- WELL COMPLETION DATA:
- (1) diameter (inches) 4"
 - (2) total depth (feet) 130
 - (3) static water level (feet) 30 below top of ground.
 - (4) casing Plastic Bottom
(material) (depth)
 - (size) If telescope see back.
 - (5) screen 6' 120'
(length) (depth to top)
 - 4" Plastic
(size) (material)
 - (6) pump 3/4" Sub 17
(HP) (yield gpm)
 - Elect
(type power)
 - (7) electric log NO
(yes or no)

(organization running log)

(8) how well bottom plugged wooden plug


DRILLERS REMARKS: old well bed

CODED

MAY 27 1968
MISS. BOARD OF
WATER COMMISSIONERS

If well telescopes please sketch and show depths.

GROUND LEVEL

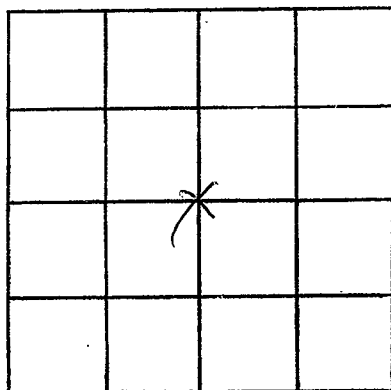

SECTION 53

Please indicate well location X.

ADDITIONAL INFORMATION

If more than one screen,
show locations of each on sketch.