

PIKE  
B 50 CODED  
5-68

MISSISSIPPI  
BOARD OF WATER COMMISSIONERS  
416 North State Street  
Jackson, Mississippi 39201

WATER WELL DRILLERS LOG

5-14 1968 Fitzgerald well serv Pike  
date well completed firm name county well located

LANDOWNER: Boak T. Butler  
R.R. Summit, Miss.  
(mailing address)


description of formations encountered	from	to
<u>Red Clay</u>	<u>0</u>	<u>15</u>
<u>Red Sand</u>	<u>15</u>	<u>40</u>
<u>Red gravel</u>	<u>40</u>	<u>100</u>
<u>Red sand</u>	<u>100</u>	<u>120</u>
<u>Coarse sand &amp; gravel</u>	<u>120</u>	<u>156</u>

WELL LOCATION:  
sec. 1 T. 4 N. R. 8 E  
9 miles NE of Summit  
(distance) (direction) (nearest town)

WELL PURPOSE: domestic  
(home, irrigation, municipal, industrial)

- WELL COMPLETION DATA:
- (1) diameter (inches) 4"
  - (2) total depth (feet) 156
  - (3) static water level (feet) 110 below above top of ground.
  - (4) casing Plaster, 150'  
(material) (depth)  
4" If telescope see back.  
(size)
  - (5) screen 6', 150'  
(length) (depth to top)  
4", Plaster  
(size) (material)
  - (6) pump 1/2 10  
(HP) (yield gpm)  
Elco  
(type power)
  - (7) electric log No  
(yes or no)  
\_\_\_\_\_  
(organization running log)
  - (8) how well bottom plugged wood peg


CODED

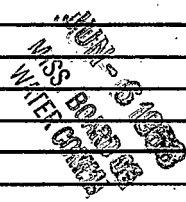

DRILLERS REMARKS:

If well telescopes please sketch and show depths.

GROUND LEVEL

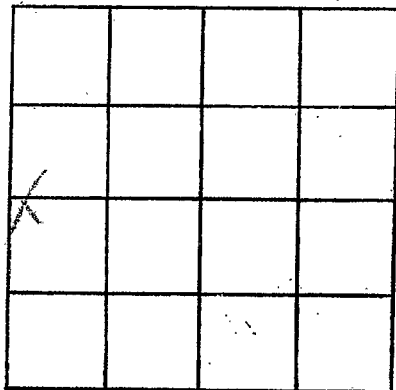

SECTION 1

Please indicate well location X.

ADDITIONAL INFORMATION

If more than one screen,  
show locations of each on sketch.