

**MISSISSIPPI  
BOARD OF WATER COMMISSIONERS**  
416 North State Street  
Jackson, Mississippi 39201

**WATER WELL DRILLERS LOG**

*Pike*  
*B52* CODED  
*5-68*

*May 16* 19*68* *CC Lewis Well Drillers* *Pike* -  
date well completed firm name county well located

LANDOWNER	description of formations encountered	from	to
<i>Wells Party</i> <i>FDZ, Keith - U</i>	<i>clay gravel</i>	<i>0</i>	<i>16</i>
(mailing address)	<i>small gravel</i>	<i>16</i>	<i>55</i>

**WELL LOCATION:**  
sec. *1* T *4* N R. *6* E  
*7/8* miles *NE* of *Sumner*  
(distance) (direction) (nearest town)

<i>white chalk</i>	<i>55</i>	<i>98</i>
<i>coarse sand</i>	<i>98</i>	<i>112</i>

**WELL PURPOSE:** *farm*  
(home, irrigation, municipal, industrial)

**WELL COMPLETION DATA:**

(1) diameter (inches) *4"*

(2) total depth (feet) *112*

(3) static water level (feet) *65* below top of ground

(4) casing *Plastic Bottom*  
(material) (depth)

\_\_\_\_\_ If telescope see back.  
(size)

(5) screen *6'* *106*  
(length) (depth to top)

*4"* *Plastic*  
(size) (material)

(6) pump *funny* *106*  
(type) (yield gpm)

\_\_\_\_\_ (type power)

(7) electric log *NO*  
(yes or no)

\_\_\_\_\_ (organization running log)

(8) how well bottom plugged *wooden plug*


CODED

JUL 27 1968  
MISS. BOARD OF  
WATER COM.

**DRILLERS REMARKS:**  
*New location*

If well telescopes please sketch and show depths.

GROUND LEVEL

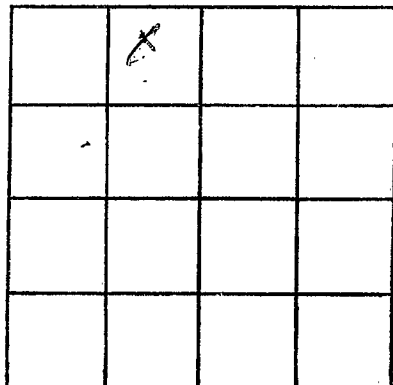

SECTION 1

Please indicate well location X.

ADDITIONAL INFORMATION

If more than one screen,  
show locations of each on sketch.