

**MISSISSIPPI  
BOARD OF WATER COMMISSIONERS**  
416 North State Street  
Jackson, Mississippi 39201

CODED

**WATER WELL DRILLERS LOG**

<i>Pike</i>	CODED
<i>B 54</i>	
<i>11-14-68</i>	

*Nov. 14* 19 *68* *J. T. Coastington* *Pike*  
 date well completed firm name county well located

LANDOWNER: *M. L. McFatt*

description of formations encountered

from

to

*Summit, Miss.*  
(mailing address)

<i>clay</i>	<i>0</i>	<i>45</i>
<i>sand &amp; pebbles</i>	<i>45</i>	<i>90</i>
<i>clay</i>	<i>90</i>	<i>160</i>
<i>sand &amp; pebbles</i>	<i>160</i>	<i>212</i>

WELL LOCATION:

sec. *19* T. *4* N. R. *5* E  
 S W  
*1* miles *East* of *Southmost*  
 (distance) (direction) (nearest town)

WELL PURPOSE: *Home*  
 (home, irrigation, municipal, industrial)

CODED

WELL COMPLETION DATA:

- (1) diameter (inches) *4"*
- (2) total depth (feet) *212'*
- (3) static water level (feet) *160'* below above top of ground.
- (4) casing *Plastic, 206'*  
 (material) (depth)  
 (size) If telescope see back.
- (5) screen *6'* *20'*  
 (length) (depth to top)  
*4"* *Plastic*  
 (size) (material)
- (6) pump ~~*7*~~ *7*  
 (HP) (yield gpm)  
*A.C.*  
 (type power)
- (7) electric log \_\_\_\_\_  
 (yes or no)  
 \_\_\_\_\_  
 (organization running log)
- (8) how well bottom plugged *wood*


DRILLERS REMARKS:

REC 23 1968

MISS. BD. OF  
 WATER COMMISSIONERS

If well telescopes please sketch and show depths.

GROUND LEVEL

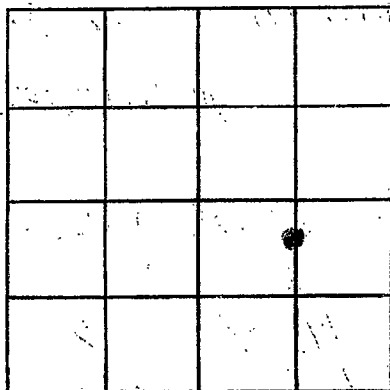

SECTION 19

Please indicate well location X.

ADDITIONAL INFORMATION

If more than one screen, show locations of each on sketch.