

Rike CODED
 B55
 12-10-68

MISSISSIPPI
 BOARD OF WATER COMMISSIONERS
 416 North State Street
 Jackson, Mississippi 39201

CODED

WATER WELL DRILLERS LOG

Dec 10 1968 J. T. Courington Pitka
 date well completed firm name county well located

LANDOWNER: Mrs. Hughie Jackson

description of formations encountered	from	to
---------------------------------------	------	----

Summit, Miss
 (mailing address)

WELL LOCATION:
 sec ~~1~~ T ~~4~~ N R ~~8~~ E
 S W
 8 miles N.E. of Summit
 (distance) (direction) (nearest town)

WELL PURPOSE: Home
 (home, irrigation, municipal, industrial)

WELL COMPLETION DATA:


- (1) diameter (inches) 11"
- (2) total depth (feet) 108
- (3) static water level (feet) 80' below top of ground.
- (4) casing Plastic, 102' (material) (depth)
- (size) If telescope see back.
- (5) screen 6' 108' (length) (depth to top)
- 4" Plastic (size) (material)
- (6) pump 2 8 (HP) (yield gpm)
- A.C. (type power)
- (7) electric log (yes or no)
- (organization running log)
- (8) how well bottom plugged wood

DRILLERS REMARKS:

DEC 28 1968
 MISS. DEP. OF WATER RESOURCES

If well telescopes please sketch and show depths.

GROUND LEVEL

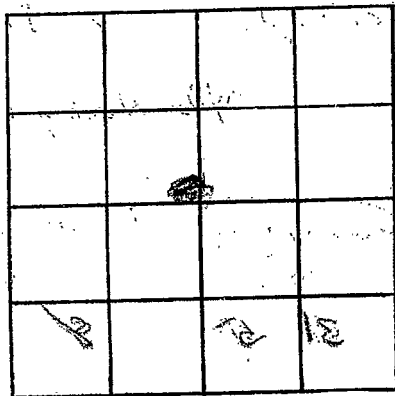

SECTION ~~2~~

Please indicate well location X.

ADDITIONAL INFORMATION

If more than one screen, show locations of each on sketch.