

Pike CODED
 B56
 1-23-69

MISSISSIPPI
 BOARD OF WATER COMMISSIONERS
 416 North State Street
 Jackson, Mississippi 39201 CODED

WATER WELL DRILLERS LOG

1-23-69 *Leonard Water Well* *Pike*
 date well completed firm name county well located

LANDOWNER: *R. Turner*
Summit St Miss

description of formations encountered	from	to
<i>Red Clay</i>	<i>0</i>	<i>20</i>
<i>Red Sand</i>	<i>20</i>	<i>80</i>
<i>Red sand + gravel</i>	<i>80</i>	<i>90</i>
<i>Coarse sand + gravel</i>	<i>90</i>	<i>103</i>

(mailing address)

WELL LOCATION:
 sec *21* T *4* N R *8* E
3 miles NE of *Summit*
 (distance) (direction) (nearest town)

WELL PURPOSE: *Home*
 (home, irrigation, municipal, industrial)

WELL COMPLETION DATA:

- (1) diameter (inches) ~~3~~ *4"*
- (2) total depth (feet) *103'*
- (3) static water level (feet) *75* below top of ground.
- (4) casing *plaster 97'*
 (material) (depth)
4 if telescope see back.
 (size)
- (5) screen *6* *97'*
 (length) (depth to top)
4 *plaster*
 (size) (material)
- (6) pump *1/2* *4*
 (HP) (yield gpm)
elec
 (type power)
- (7) electric log *No*
 (yes or no)
 (organization running log)
- (8) how well bottom plugged *wood peg*


CODED

FEB 19 1969
 MISS. DIV. OF
 WATER CONTROL

DRILLERS REMARKS:

If well telescopes please sketch and show depths.

GROUND LEVEL

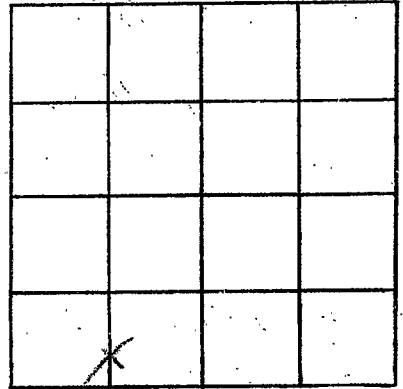

SECTION 21

Please indicate well location X.

ADDITIONAL INFORMATION

If more than one screen,
show locations of each on sketch.