

Dike  
B57  
3-31-69

MISSISSIPPI  
 BOARD OF WATER COMMISSIONERS  
 416 North State Street  
 Jackson, Mississippi 39201

CODED  
 CODED

WATER WELL DRILLERS LOG

3-31 19 69 Fitzgerald Well Serv Dike  
 date well completed firm name county well located

LANDOWNER:  
R. Hutson  
R.R. Summit Miss.  
 (mailing address)

description of formations encountered	from	to
<u>Red clay</u>	<u>0</u>	<u>20</u>
<u>Red gravel</u>	<u>20</u>	<u>80</u>
<u>Red Sand</u>	<u>80</u>	<u>120</u>
<u>Coarse sand &amp; gravel</u>	<u>120</u>	<u>135</u>

WELL LOCATION:  
 sec. 7 T. 4 N. R. 8 E.  
 S. W.  
4 miles N of Summit  
 (distance) (direction) (nearest town)

WELL PURPOSE: Home  
 (home, irrigation, municipal, industrial)

- WELL COMPLETION DATA:
- (1) diameter (inches) 4
  - (2) total depth (feet) 135
  - (3) static water level (feet) 95 below above top of ground.
  - (4) casing Plastic, 129,  
 (material) (depth)  
4 if telescope see back.  
 (size)
  - (5) screen 6, 129  
 (length) (depth to top)  
4, Plastic  
 (size) (material)
  - (6) pump 1/2, 12  
 (HP) (yield gpm)  
Electric  
 (type power)
  - (7) electric log No  
 (yes or no)  
 (organization running log)
  - (8) how well bottom plugged Wood plug

CODED


APR 22 1969

MISSISSIPPI  
 WATER BOARD

DRILLERS REMARKS:

If well telescopes please sketch and show depths.

GROUND LEVEL

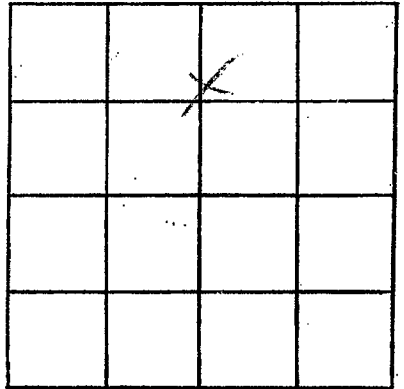

SECTION 7

Please indicate well location X.

ADDITIONAL INFORMATION

Lined area for additional information.

If more than one screen, show locations of each on sketch.