

MISSISSIPPI
BOARD OF WATER COMMISSIONERS
 416 North State Street
 Jackson, Mississippi 39201

CODED

WATER WELL DRILLERS LOG

Dike
B 58
3-31-69

3-31 19*69* *Fitzgerald well dr* *Dike*
 date well completed firm name county well located

LANDOWNER:

A. Staughton
R.R. Summit, Miss.
 (mailing address)

description of formations encountered

from to

<i>Red Clay</i>	<i>0</i>	<i>20</i>
<i>Red Silt</i>	<i>20</i>	<i>30</i>
<i>White clay</i>	<i>80</i>	<i>110</i>
<i>Fine sand</i>	<i>110</i>	<i>130</i>
<i>Coarse sand</i>	<i>130</i>	<i>140</i>

WELL LOCATION:

sec. *7* T. *4* N. R. *8* E. S. *W*
4 miles *N* of *Summit*
 (distance) (direction) (nearest town)

WELL PURPOSE:

Home
 (home, irrigation, municipal, industrial)

WELL COMPLETION DATA:

- (1) diameter (inches) *4*
- (2) total depth (feet) *140*
- (3) static water level (feet) *90* below above top of ground.
- (4) casing *Plastic, 134.*
 (material) (depth)
- 4* If telescope see back.
 (size)
- (5) screen *6 134*
 (length) (depth to top)
- 4* *Plastic*
 (size) (material)
- (6) pump *1/2 12*
 (HP) (yield gpm)
- Electric*
 (type power)
- (7) electric log *Yes*
 (yes or no)
- (organization running log)
- (8) how well bottom plugged *Used py*


FOUNT

DRILLERS REMARKS:

APR 30 1969
MISSISSIPPI BOARD OF WATER COMMISSIONERS

If well telescopes please sketch and show depths.

GROUND LEVEL

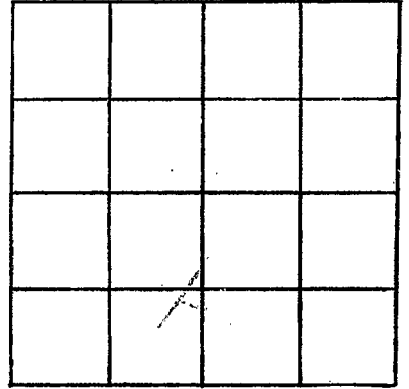

SECTION 7

Please indicate well location X.

ADDITIONAL INFORMATION

If more than one screen,
show locations of each on sketch.