

Pike
B59
7-69

MISSISSIPPI
BOARD OF WATER COMMISSIONERS
416 North State Street
Jackson, Mississippi 39201

CODED

WATER WELL DRILLERS LOG

7-30 1969 *Fitzgerald* *Pike*
date well completed firm name county well located

LANDOWNER:
Ruston R. Kelly's
R.R. Summit, Miss.
(mailing address)

| description of formations encountered | from | to |
|---------------------------------------|------------|------------|
| <i>Red clay</i> | <i>0</i> | <i>20</i> |
| <i>Red sand</i> | <i>20</i> | <i>80</i> |
| <i>white clay</i> | <i>80</i> | <i>130</i> |
| <i>Coarse sand</i> | <i>130</i> | <i>150</i> |

WELL LOCATION:
sec. *9* T. *4* N. R. *8* E.
S. W.
3 miles *NE* of *Summit*
(distance) (direction) (nearest town)

WELL PURPOSE: *Home*
(home, irrigation, municipal, industrial)

- WELL COMPLETION DATA:
- (1) diameter (inches) *4*
 - (2) total depth (feet) *150*
 - (3) static water level (feet) *95* below above top of ground.
 - (4) casing *Plastic*, *144*,
(material) (depth)
4 if telescope see back.
(size)
 - (5) screen *6*, *944*
(length) (depth to top)
4, *plastic*
(size) (material)
 - (6) pump *7*, *7*
(HP) (yield gpm)
Electric
(type power)
 - (7) electric log *no*
(yes or no)
(organization running log)
 - (8) how well bottom plugged *Wood peg*


CODED

LOG A 15
DIS. ON C
WATER CO.

DRILLERS REMARKS:

If well telescopes please
sketch and show depths.

GROUND LEVEL

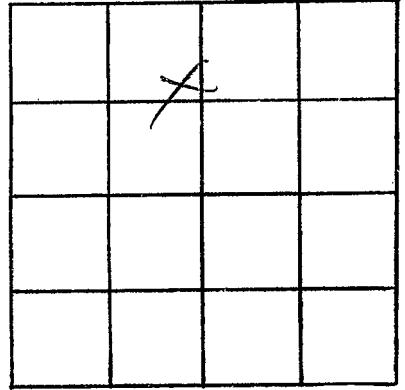

SECTION 9

Please indicate well location X.

ADDITIONAL INFORMATION

If more than one screen,
show locations of each on sketch.