

CODED

MISSISSIPPI
BOARD OF WATER COMMISSIONERS
416 North State Street
Jackson, Mississippi 39201

WATER WELL DRILLERS LOG

Pike JDED
B61
8-68

Aug 3 1968 date well completed
68 Reeves well pumps firm name
Pike county well located

LANDOWNER

description of formations encountered

from

to

Frank
Bursky
PTD Hayes
(mailing address)

red clay 0 11
red sand 11 30
sand & gravel 30 50
red sand 50 80
red chalk 80 82
clean gravel 82 90

WELL LOCATION:

sec 10 T 4 N R 8 E
2 miles WNE of Pinedale (direction) (nearest town)

WELL PURPOSE: Home -
(home, irrigation, municipal, industrial)


WELL COMPLETION DATA:

- (1) diameter (inches) 4
- (2) total depth (feet) 90
- (3) static water level (feet) 54 below top of ground.
- (4) casing Plastic ballans (material) (depth)
- (size) if telescope see back.
- (5) screen 6' 84 (length) (depth to top)
- 4" Plastic (size) (material)
- (6) pump 1/2 HP 12 (yield gpm)
- elect (type power)
- (7) electric log NO (yes or no)

(organization running log)


(8) how well bottom plugged
wooden plug

DRILLERS REMARKS:
old well dry

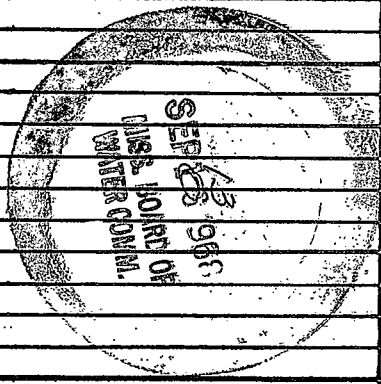

If well telescopes please sketch and show depths.

GROUND LEVEL

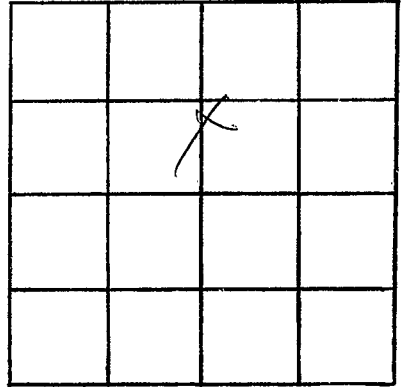

SECTION 15

Please indicate well location X.

ADDITIONAL INFORMATION

If more than one screen,
show locations of each on sketch.