

**MISSISSIPPI
BOARD OF WATER COMMISSIONERS
416 North State Street
Jackson, Mississippi 39201**

WATER WELL DRILLERS LOG

Pike Co
B 62
3-30-70

March 30 1970 Reeves Well & Pump Co. Pike
date well completed firm name county well located

LANDOWNER: Albert Buster
Rt-3, McComb.
(mailing address)

description of formations encountered	from	to
Clay	0	8
sand & gravel	8	32
Blue clay	32	90
fine sand	90	105
coarse sand	105	121

WELL LOCATION:
sec 32 T 4 N R 9 E 005
3 miles SSE of Summit
(distance) (direction) (nearest town)

WELL PURPOSE: Farm
(home, irrigation, municipal, industrial)

WELL COMPLETION DATA:

(1) diameter (inches) 4"

(2) total depth (feet) 121

(3) static water level (feet) 20' below top of ground.

(4) casing (material) (depth) Plastic bottom

(size) If telescope see back.

(5) screen (length) 6' (depth to top) 115'

(size) (material) 4" Plastic

(6) pump (HP) (yield gpm) 1/2 HP old bottom pump

(type power) electric

(7) electric log (yes or no) no

(organization running log)

MAY 14 1970

MISS. Bd. of WATER


(8) how well bottom plugged
wooden plug

DRILLERS REMARKS:
old well

REEVES WELL & PUMP CO.
P. O. BOX 71 -- PHONE (664-1450)
McCOMB, MISS.

If well telescopes please sketch and show depths.

GROUND LEVEL

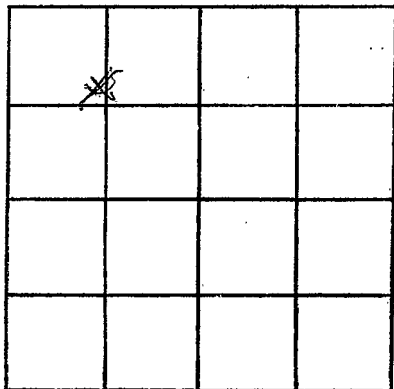

SECTION 32

Please indicate well location X.

ADDITIONAL INFORMATION

If more than one screen,
show locations of each on sketch.