

Pike Co
 B 63
 4-1-70

MISSISSIPPI
 BOARD OF WATER COMMISSIONERS
 416 North State Street
 Jackson, Mississippi 39201

WATER WELL DRILLERS LOG

April 1970 date well completed
 Chester Kemp firm name
 Pike county well located

LANDOWNER Robert Walker
 RFD 2, Ruth

description of formations encountered	from	to
Red clay	0	22
Red sand	22	60
chick, sand & gravel	60	90
small sand & gravel	90	117

(mailing address)

WELL LOCATION:
 sec. 11 T. 4 N. R. 6 E. 065
 1/2 miles NE of Summit
 (distance) (direction) (nearest town)

WELL PURPOSE: Home
 (home, irrigation, municipal, industrial)

WELL COMPLETION DATA:


- (1) diameter (inches) 4"
- (2) total depth (feet) 117
- (3) static water level (feet) 66 below top of ground.
- (4) casing Plastic Ballast (material) (depth)
- (size) if telescope see back.
- (5) screen 6 111 (length) (depth to top)
 4" Plastic (size) (material)
- (6) pump old jet pump (HP) (yield gpm)
 Electric (type power)
- (7) electric log NO (yes or no)
- (organization running log)
- (8) how well bottom plugged
 water plug

DRILLERS REMARKS:
 old well bad

MAY 14 1970

If well telescopes please sketch and show depths.

GROUND LEVEL

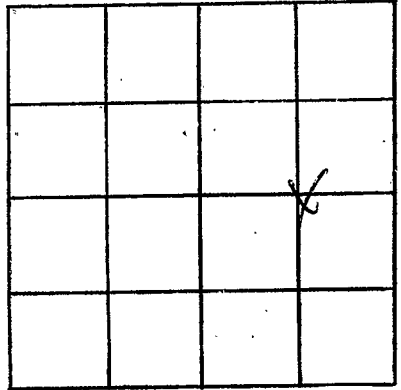

SECTION 11

Please indicate well location X.

ADDITIONAL INFORMATION

If more than one screen,
show locations of each on sketch.