

Pike Co  
 B 64  
 4-20-70

MISSISSIPPI  
 BOARD OF WATER COMMISSIONERS  
 416 North State Street  
 Jackson, Mississippi 39201

WATER WELL DRILLERS LOG

20 April 1970 AT. Cunningham & Son Pike  
 date well completed firm name county well located

LANDOWNER:  
 Hilton Washington  
 Summit  
 (mailing address)

WELL LOCATION: 168  
 sec 36 T 4 N R 9 E  
 1 miles East of Summit  
 (distance) (direction) (nearest town)

description of formations encountered	from to	
	feet	feet
Red clay	0	10
Chalk sand	10	20
Chalk	20	30
Good chuffs	30	45
Good	45	73

WELL PURPOSE:  
 (home, irrigation, municipal, industrial)

- WELL COMPLETION DATA:
- (1) diameter (inches) 4
  - (2) total depth (feet) 73
  - (3) static water level (feet) 55 below top of ground.
  - (4) casing PI 57  
 (material) (depth)  
 4 If telescope see back.  
 (size)
  - (5) screen 6 67  
 (length) (depth to top)  
 4 PI  
 (size) (material)
  - (6) pump 1/2 10  
 (HP) (yield gpm)  
 elect  
 (type power)
  - (7) electric log (yes or no)

(organization running log)

(8) how well bottom plugged *none*


MAY 18 1970

DRILLERS REMARKS:

MISS. BD. OF  
 WATER COMM.

If well telescopes please sketch and show depths.

GROUND LEVEL

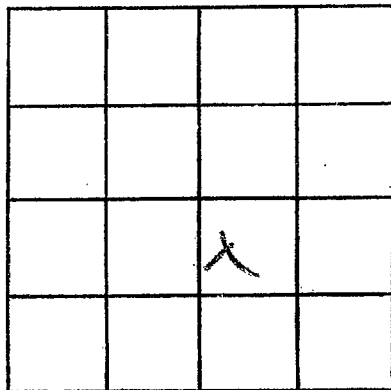

SECTION 36

Please indicate well location X.

ADDITIONAL INFORMATION

If more than one screen, show locations of each on sketch.