

MISSISSIPPI  
BOARD OF WATER COMMISSIONERS  
416 North State Street  
Jackson, Mississippi 39201

**CODED**

WATER WELL DRILLERS LOG

PIKE  
B65  
7-2-70

July 2 1970 Chester Keene Pike  
 date well completed firm name county well located

LANDOWNER:	description of formations encountered	from	to
<u>W.A. Williams</u>			
<u>M. Lamb</u> (mailing address)	<u>Red Clay</u>	<u>0</u>	<u>10</u>
	<u>white chalk</u>	<u>10</u>	<u>80</u>
	<u>fine sand</u>	<u>80</u>	<u>100</u>
	<u>white sand &amp; gravel</u>	<u>100</u>	<u>140</u>

WELL LOCATION:

sec. 33 T. 4 N. R. 5 E  
2 1/2 miles NE of McLamb  
 (distance) (direction) (nearest town)

WELL PURPOSE:

house  
 (home, irrigation, municipal, industrial)

WELL COMPLETION DATA:

- (1) diameter (inches) 4"
- (2) total depth (feet) 140
- (3) static water level (feet) 34 below top of ground.
- (4) casing plastic bottom  
 (material) (depth)
- (size) if telescope see back.
- (5) screen 6' 134'  
 (length) (depth to top)
- (size) (material)
- (6) pump 3/8 sub 15  
 (HP) (yield gpm)
- (type power)
- (7) electric log no  
 (yes or no)
- (organization running log)

**COVER**


(8) how well bottom plugged  
wooden plug

DRILLERS REMARKS:  
old 2 wells  
bad

SEP 15 1970

If well telescopes please sketch and show depths.

GROUND LEVEL

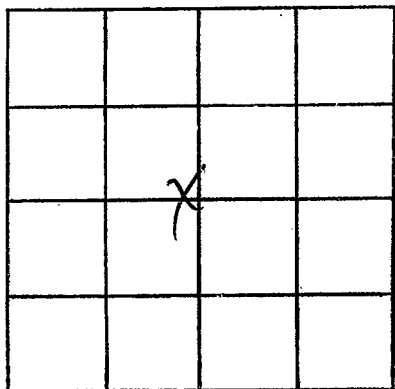

SECTION 33

Please indicate well location X.

ADDITIONAL INFORMATION

If more than one screen,  
show locations of each on sketch.