

PIKE  
B66  
8-20-70

MISSISSIPPI  
BOARD OF WATER COMMISSIONERS  
416 North State Street  
Jackson, Mississippi 39201

**CODED**

WATER WELL DRILLERS LOG

Aug 20 1970 *Chester Keener* *Pike*  
date well completed firm name county well located

LANDOWNER: *Northlife school*  
*Summit*  
(mailing address)

WELL LOCATION:  
sec. *19* T *4* N R *8* E  
*2* miles *NE* of *Summit*  
(distance) (direction) (nearest town)

WELL PURPOSE: *school*  
(home, irrigation, municipal, industrial)

- WELL COMPLETION DATA:
- (1) diameter (inches) *4"*
  - (2) total depth (feet) *130*
  - (3) static water level (feet) *64* below top of ground.
  - (4) casing *Plastic bottom*  
(material) (depth)
  - (size) if telescope see back.
  - (5) screen *16'* *1 1/4'*  
(length) (depth to top)  
*4"* *Plastic*  
(size) (material)
  - (6) pump *1/2 Sub* *15*  
(HP) (yield gpm)  
*Electric*  
(type power)
  - (7) electric log *No*  
(yes or no)
  - (organization running log)

Description of formations encountered	from	to
<i>Red clay</i>	<i>0</i>	<i>18</i>
<i>Red Sand &amp; gravel</i>	<i>18</i>	<i>90</i>
<i>White sand &amp; chalk, gravel</i>	<i>90</i>	<i>112</i>
<i>Sand &amp; gravel</i>	<i>112</i>	<i>130</i>

**CODED**

(8) how well bottom plugged *wooden plug*


DRILLERS REMARKS:  
*1/2 HP - 30 gal/min pump & oil installed*

SEP 21 1970

MISS. BD. OF  
WATER COMMISSIONERS

If well telescopes please sketch and show depths.

GROUND LEVEL

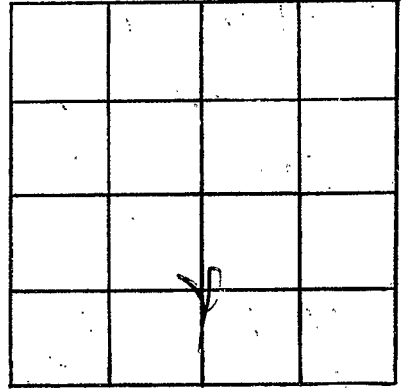

SECTION 19

Please indicate well location X.

ADDITIONAL INFORMATION

If more than one screen,  
show locations of each on sketch.