

Pike
B67
5-15-70

MISSISSIPPI
BOARD OF WATER COMMISSIONERS
416 North State Street
Jackson, Mississippi 39201

CODED

WATER WELL DRILLERS LOG

May 15 1970 Chester Kernes Pike
date well completed firm name county well located

LANDOWNER: Dianna
Blum
RFD Summit
(mailing address)

description of formations encountered

from to

red clay	0	12
red sand clay	12	55
red sand shale	55	125
small gravel band	125	140

WELL LOCATION:

sec. 10 T. 4 R. 8
6 miles SW of Summit
(distance) (direction) (nearest town)

WELL PURPOSE: Drinking
(home, irrigation, municipal, industrial)

WELL COMPLETION DATA:

- (1) diameter (inches) 4"
- (2) total depth (feet) 140
- (3) static water level (feet) 90 below top of ground
- (4) casing Plastic (material) bottom (depth)

(size) if telescope see back.

- (5) screen 6' (length) 134' (depth to top)
4" (size) Plastic (material)

- (6) pump 1/2 Sub (HP) 12 (yield gpm)
Elect (type power)

- (7) electric log no (yes or no)

(organization running log)

- (8) how well bottom plugged wooden plug

DRILLERS REMARKS: old well bad


CODED

JUL 27 1970

MISS. BD. OF
WATER COMM.

If well telescopes please sketch and show depths.

GROUND LEVEL

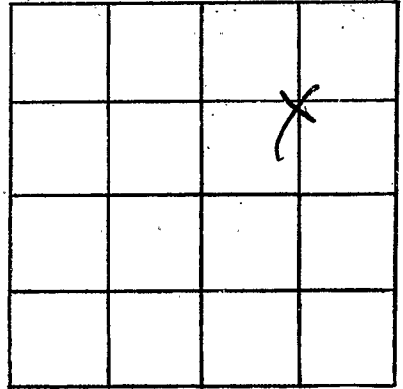

SECTION 10

Please indicate well location X.

ADDITIONAL INFORMATION

If more than one screen,
show locations of each on sketch.