

Pike  
B 68  
5-27-70

MISSISSIPPI  
BOARD OF WATER COMMISSIONERS  
416 North State Street  
Jackson, Mississippi 39201

**CODED**

WATER WELL DRILLERS LOG

Pike

May 27 1970 Chester Keene firm name  
date well completed county well located

LANDOWNER: Don Morgan  
H-2, Ruth-

description of formations encountered	from	to
<u>Red clay</u>	<u>0</u>	<u>15</u>
<u>Sand</u>	<u>15</u>	<u>20</u>
<u>pink chert gravel</u>	<u>20</u>	<u>45</u>
<u>Sand &amp; chert gravel</u>	<u>45</u>	<u>102</u>

(mailing address)

WELL LOCATION:  
sec. 1 T. 4 N R. 8 E  
10 miles SW of Summit  
(distance) (direction) (nearest town)

WELL PURPOSE: Home  
(home, irrigation, municipal, industrial)

WELL COMPLETION DATA:

- (1) diameter (inches) 4
- (2) total depth (feet) 102
- (3) static water level (feet) 50 below above top of ground.
- (4) casing Plastic bottom  
(material) (depth)
- (size) if telescope see back.
- (5) screen 6' 96'  
(length) (depth to top)
- 4" Plastic  
(size) (material)
- (6) pump compressed  
(HP) (yield gpm)
- Rump elect.  
(type power)
- (7) electric log NO  
(yes or no)
- (organization running log)

**CODED**

(8) how well bottom plugged  
completely


DRILLERS REMARKS: red well  
had water has  
slight salty taste

JUL 27 1970

MISS. RD. COM.  
WATER COMM.

If well telescopes please sketch and show depths.

GROUND LEVEL

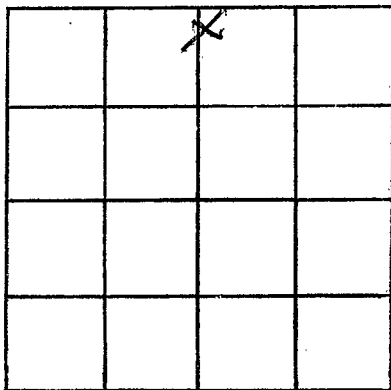

SECTION 1

Please indicate well location X.

ADDITIONAL INFORMATION

If more than one screen,  
show locations of each on sketch.