

DIKE
B 69
8-13-70

MISSISSIPPI
 BOARD OF WATER COMMISSIONERS
 416 North State Street
 Jackson, Mississippi 39201

CODED

WATER WELL DRILLERS LOG

8-13 1970 Fitzgerald Well Co Dike
 date well completed firm name county well located

LANDOWNER:
Fred Felber
P.O. Box 277 Comb, Miss
 (mailing address)

description of formations encountered	from	to
<u>Red Clay</u>	<u>8</u>	<u>25</u>
<u>Coarse sand</u>	<u>13</u>	<u>80</u>
<u>Coarse sand & gravel</u>	<u>80</u>	<u>88</u>

WELL LOCATION:
 sec. 36 T 4 N R 8 E
6 miles E of Comb
 (distance) (direction) (nearest town)

WELL PURPOSE: Home
 (home, irrigation, municipal, industrial)

WELL COMPLETION DATA:

(1) diameter (inches) 4

(2) total depth (feet) 88

(3) static water level (feet) 15 below top of ground.

(4) casing plastic 80
 (material) (depth)
4 if telescope see back.
 (size)

(5) screen 8 80
 (length) (depth to top)
4 plastic
 (size) (material)

(6) pump 1/2 12
 (HP) (yield gpm)
el
 (type power)

(7) electric log no
 (yes or no)

CODED

(organization running log)

(8) how well bottom plugged wool plug


AUG 17 1970

DRILLERS REMARKS:

MISS. BD. OF
 WATER COMM.

If well telescopes please sketch and show depths.

GROUND LEVEL

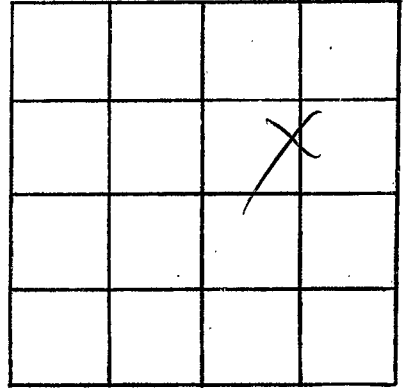

SECTION 36

Please indicate well location X.

ADDITIONAL INFORMATION

If more than one screen, show locations of each on sketch.