

PIKE
B 70
9-14-70

MISSISSIPPI
BOARD OF WATER COMMISSIONERS
416 North State Street
Jackson, Mississippi 39201

CODED

WATER WELL DRILLERS LOG

9-14 1970 Fitzgerald Well Dr Pike
date well completed firm name county well located

LANDOWNER:
Wilder Smith
P.O. Summit Miss.
(mailing address)

description of formations encountered	from	to
<u>Red clay</u>	<u>0</u>	<u>20</u>
<u>Red sand</u>	<u>25</u>	<u>80</u>
<u>Red gravel</u>	<u>80</u>	<u>110</u>
<u>Coarse sand & gravel</u>	<u>110</u>	<u>124</u>

WELL LOCATION:
sec. 14 T. 4 N. R. 8 E.
8 miles ENE of Summit
(distance) (direction) (nearest town)

WELL PURPOSE: Elm
(home, irrigation, municipal, industrial)

- WELL COMPLETION DATA:
- (1) diameter (inches) 4
 - (2) total depth (feet) 124
 - (3) static water level (feet) 80 below above top of ground.
 - (4) casing plastic, 116,
(material) (depth)
4 if telescope see back.
(size)
 - (5) screen 8, 116
(length) (depth to top)
4, plastic
(size) (material)
 - (6) pump 1, 6
(HP) (yield gpm)
Elm
(type power)
 - (7) electric log ny
(yes or no)
(organization running log)
 - (8) how well bottom plugged covered by

CODED


OCT 16 1970

MISS. BD. OF
WATER COMM.

DRILLERS REMARKS:

If well telescopes please sketch and show depths.

GROUND LEVEL

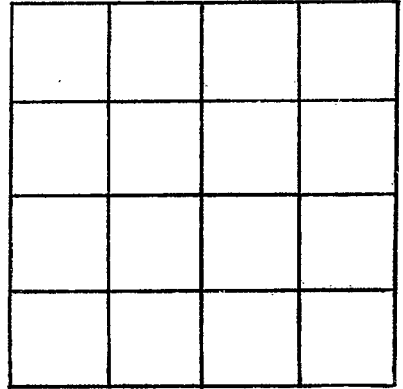

SECTION _____

Please indicate well location X.

ADDITIONAL INFORMATION

If more than one screen, show locations of each on sketch.