

PIKE  
B 71  
9-29-70

MISSISSIPPI  
BOARD OF WATER COMMISSIONERS  
416 North State Street  
Jackson, Mississippi 39201

**CODED**

WATER WELL DRILLERS LOG

9-29 1970 *Fitzgerald* *Pike*  
date well completed firm name county well located

LANDOWNER:  
*W.M. Kennedy*  
*P.O. Box 1000*  
(mailing address)

description of formations encountered	from	to
<i>red clay</i>	<i>0</i>	<i>20</i>
<i>red sand</i>	<i>20</i>	<i>65</i>
<i>white chalk</i>	<i>65</i>	<i>150</i>
<i>lime soil</i>	<i>150</i>	<i>165</i>
<i>concrete soil</i>	<i>165</i>	<i>175</i>

WELL LOCATION:  
sec. *33* T *4* N R *8* E  
S W  
*4* miles *E* of *Summitt*  
(distance) (direction) (nearest town)

WELL PURPOSE: *Home*  
(home, irrigation, municipal, industrial)

- WELL COMPLETION DATA:
- (1) diameter (inches) *4*
  - (2) total depth (feet) *175*
  - (3) static water level (feet) *65* below top of ground.
  - (4) casing *plastic*, *167*,  
(material) (depth)  
*4* if telescope see back.  
(size)
  - (5) screen *8*, *167*  
(length) (depth to top)
  - 4*, *plastic*  
(size) (material)
  - (6) pump *1/2*, *10*  
(HP) (yield gpm)
  - elec*  
(type power)
  - (7) electric log *no*  
(yes or no)  
(organization running log)
  - (8) how well bottom plugged *woolyn*

**CODED**


OCT 16 1970

DRILLERS REMARKS:

MISS. BD. OF  
WATER COM.

If well telescopes please sketch and show depths.

GROUND LEVEL

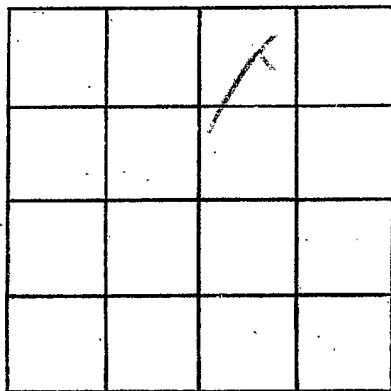

SECTION 2

Please indicate well location X.

ADDITIONAL INFORMATION

If more than one screen,  
show locations of each on sketch.