

PIKE  
B 72  
10-13-70

MISSISSIPPI  
BOARD OF WATER COMMISSIONERS  
416 North State Street  
Jackson, Mississippi 39201

**CODED**

WATER WELL DRILLERS LOG

Oct 13 1970 *Charles Reeves* *Pike*  
date well completed firm name county well located

LANDOWNER: *Altam M. Bushy - RFD 1, Summit*  
(mailing address)

description of formations encountered	from	to
<i>chalk</i>	<i>0</i>	<i>15</i>
<i>Sand, fine gravel - Big gravel</i>	<i>15</i>	<i>51</i>

WELL LOCATION:  
sec. *22* T. *4* N R. *8* E  
*5* miles *NE* of *Summit*  
(distance) (direction) (nearest town)

WELL PURPOSE: *Home*  
(home, irrigation, municipal, industrial)

- WELL COMPLETION DATA:
- (1) diameter (inches) *6"*
  - (2) total depth (feet) *51*
  - (3) static water level (feet) *17* below top of ground.
  - (4) casing *Plastic, Ballman*  
(material) (depth)
  - (size) if telescope see back.
  - (5) screen *6'* *45'*  
(length) (depth to top)  
*4"* *Plastic*  
(size) (material)
  - (6) pump *old Jet pump*  
(HP) (yield gpm)
  - (type power)
  - (7) electric log *no*  
(yes or no)
  - (organization running log)

**CODED**


(8) how well bottom plugged *wooden plug*  
DRILLERS REMARKS: *old 2" well bottom*

NOV 16 1970

MISS. BD. OF  
WATER COMM.

If well telescopes please sketch and show depths.

GROUND LEVEL

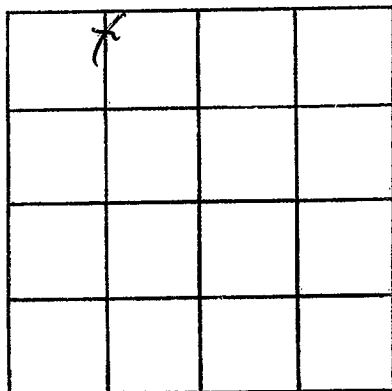

SECTION 22

Please indicate well location X.

ADDITIONAL INFORMATION

If more than one screen, show locations of each on sketch.