

MISSISSIPPI  
 BOARD OF WATER COMMISSIONERS  
 416 North State Street  
 Jackson, Mississippi 39201

**CODED**

WATER WELL DRILLERS LOG

PIKE  
 B 74  
 11-17-70

Nov 17 1970 date well completed  
 Chester Reeves firm name  
 Pike county well located

LANDOWNER: Nelson  
 Ball -  
 RFD, Summit -  
 (mailing address)

WELL LOCATION:  
 sec. 1 T. 4 N. R. 8 E  
 4 miles N-NE of Summit  
 (distance) (direction) (nearest town)

WELL PURPOSE: Home - Dairy  
 (home, irrigation, municipal, industrial)

- WELL COMPLETION DATA:
- (1) diameter (inches) 4"
  - (2) total depth (feet) 71
  - (3) static water level (feet) 12 below top of ground.
  - (4) casing Plastic Ballast (material) (depth)
  - (5) screen 6' 65' (length) (depth to top)  
 Plastic (material)
  - (6) pump 1/2 HP (HP) 150 gpm (field gpm)  
 Jet pump (type pump)
  - (7) electric log (yes or no)

(organization running log)

(8) how well bottom plugged  
 woodchips

DRILLERS REMARKS:  
 old well had

description of formations encountered	from to	
	feet	feet
clay	0	11
sand & gravel	11	40
chalk	40	50
fine sand with coarse gravel	50	71


**CODED**

FEB 4 1971

MISS. Bd. OF WATER COMM.

If well telescopes please sketch and show depths.

GROUND LEVEL

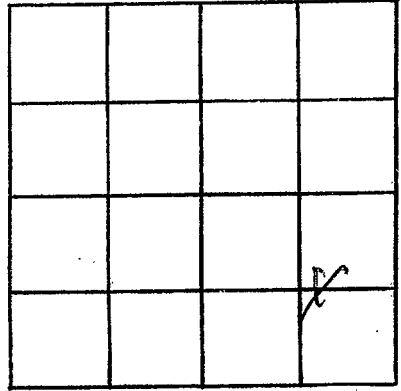

SECTION 1

Please indicate well location X.

ADDITIONAL INFORMATION

If more than one screen, show locations of each on sketch.