

PIKE
 B 75
 5-31-69

MISSISSIPPI
 BOARD OF WATER COMMISSIONERS
 416 North State Street
 Jackson, Mississippi 39201

CODED

WATER WELL DRILLERS LOG

May 31 1969 *Reveries well Drillers* *Pike*
 date well completed firm name county well located

LANDOWNER: *Ray Brewer*
Rt-1, M. G. Lamb
 (mailing address)

WELL LOCATION:
 sec. *34* T. *4* N R. *8* E
4 miles (distance) *2* (direction) *W. G. Lamb* (nearest town)

WELL PURPOSE: *same*
 (home, irrigation, municipal, industrial)

WELL COMPLETION DATA:

(1) diameter (inches) *4*

(2) total depth (feet) *118*

(3) static water level (feet) *6* below top of ground.

(4) casing *Plastic* (material) *118* (depth)

(size) If telescope see back.

(5) screen *10'* (length) *108* (depth to top)
4" (size) *Plastic* (material)

(6) pump *1 1/2 HP* (HP) *25* (yield gpm)
500W (type power)

(7) electric log *NO* (yes or no)

(organization running log)

description of formations encountered	from	to
<i>Red clay</i>	<i>0</i>	<i>24</i>
<i>Red sand</i>	<i>24</i>	<i>58</i>
<i>Gravel sand</i>	<i>58</i>	<i>72</i>
<i>white chalk</i>	<i>72</i>	<i>94</i>
<i>fine sand</i>	<i>94</i>	<i>105</i>
<i>Coars sand</i>	<i>105</i>	<i>118</i>

CODED

AUG 15 1969


MISS. Bd. of WATER COMMISSIONERS

(8) how well bottom plugged *wood chips*

DRILLERS REMARKS: *old 2" well had*

If well telescopes please sketch and show depths.

GROUND LEVEL

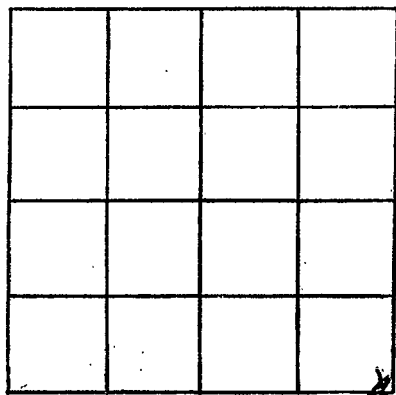

SECTION 34

Please indicate well location X.

ADDITIONAL INFORMATION

If more than one screen, show locations of each on sketch.