

PIKE
 B 76
 1-9-70

MISSISSIPPI
 BOARD OF WATER COMMISSIONERS
 416 North State Street
 Jackson, Mississippi 39201

CODED

WATER WELL DRILLERS LOG

1-9 1970 Fitzgerald well serv Pike
 date well completed firm name county well located

LANDOWNER:
Paul Hoff
R.R. Summitt miss.
 (mailing address)

description of formations encountered	from	to
<u>Red clay</u>	<u>0</u>	<u>15</u>
<u>Red sand</u>	<u>15</u>	<u>40</u>
<u>Fine sand</u>	<u>40</u>	<u>80</u>
<u>Red sand</u>	<u>80</u>	<u>95</u>
<u>Coarse sand & gravel</u>	<u>95</u>	<u>108</u>

WELL LOCATION:
 sec. 23 T 4 N R 8 E
 S W
8 miles NE of McComb
 (distance) (direction) (nearest town)

WELL PURPOSE: Home
 (home, irrigation, municipal, industrial)

- WELL COMPLETION DATA:
- (1) diameter (inches) 4
 - (2) total depth (feet) 108
 - (3) static water level (feet) 15 below top of ground.
 - (4) casing Plastic, 100
 (material) (depth)
4 if telescope see back.
 (size)
 - (5) screen 8 100
 (length) (depth to top)
4 Plastic
 (size) (material)
 - (6) pump 1/2 12
 (HP) (yield gpm)
Elco
 (type power)
 - (7) electric log No
 (yes or no)
 (organization running log)
 - (8) how well bottom plugged wood plug

CODED


JAN 20 1970

DRILLERS REMARKS:

MISS. BD. OF
 WATER COMMISSIONERS

If well telescopes please sketch and show depths.

GROUND LEVEL

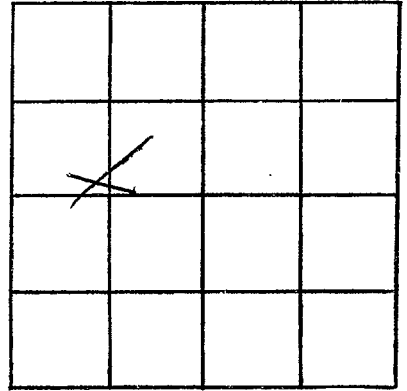

SECTION 23

Please indicate well location X.

ADDITIONAL INFORMATION

If more than one screen,
show locations of each on sketch.