

PIKE
B 78
12-29-69

MISSISSIPPI
BOARD OF WATER COMMISSIONERS
416 North State Street
Jackson, Mississippi 39201

CODED

WATER WELL DRILLERS LOG

Dec 29 1969 Kenneth W. Kump Ita
date well completed firm name county well located

LANDOWNER: Melvin Wallace
Rt 2, Ruth
(mailing address)

description of formations encountered	from	to
red clay	0	28
red sand & gravel	28	72
gravel	77	95
yellowish chalk	95	125
fine sand	125	140
red sand	140	162

WELL LOCATION:
sec. 13 T. 4 N. R. 8 E
7 miles NE of Summit
(distance) (direction) (nearest town)

WELL PURPOSE: Home
(home, irrigation, municipal, industrial)

WELL COMPLETION DATA:

- (1) diameter (inches) 4"
- (2) total depth (feet) 162
- (3) static water level (feet) 100 below top of ground.
- (4) casing Plastic Bottom
(material) (depth)
- (5) screen 6' 156
(length) (depth to top)
4" Plastic
(size) (material)
- (6) pump 1/2 Sub-12
(HP) (yield gpm)
Electric
(type power)
- (7) electric log NO
(yes or no)

CODED

(organization running log)

(8) how well bottom plugged wood chips


JAN 9 1970

DRILLERS REMARKS: New house

MISS. BD. OF
WATER COMM.

If well telescopes please sketch and show depths.

GROUND LEVEL

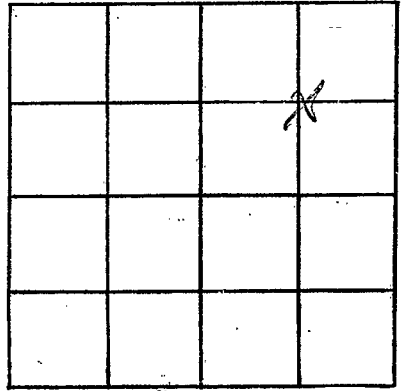

SECTION 13

Please indicate well location X.

ADDITIONAL INFORMATION

If more than one screen,
show locations of each on sketch.